

MISSISSIPPI DEPARTMENT OF NATURAL RESOURCES
Bureau of Land and Water Resources

P.O. Box 10631

Jackson, Mississippi 39209
WATER WELL DRILLERS LOG

COUNTY WELL LOCATED WAYNE	
WELL NUMBER 0008	CODED
DATE WELL COMPLETED 3/19/87	

PERMIT NUMBER 0-205
NAME OF DRILLING FIRM CARR'S WELL SER
BUCK ATONNA, MS.

NAME & MAILING ADDRESS OF LANDOWNER
COLLIE JONES

RT 4

WAYNESBORO, MS.

WELL LOCATION: SEC 17 TOWNSHIP **(N)** RANGE **(S) 6 (W)**

DISTANCE 1 1/2 Miles DIRECTION **SSE** of NEAREST TOWN **WAYNESBORO**

OTHER LANDMARK
BEHIND BECK'S MOTEL

WELL PURPOSE: Home, Irrigation, Municipal, Industrial, Fish Pond, etc.
HOME

PUMP DATA

PUMP TYPE (Circle One):
Submersible, Turbine, **(Jet)** Flowing Well,
Other (Describe) _____

POWER TYPE (Circle One):
(Electric) Tractor, Diesel, Gasoline, Butane,
Other (Describe) _____

Pump Capacity (GPM) 12	No. of Stages 2	Setting Depth 32 FT.
----------------------------------	---------------------------	--------------------------------

PUMP TEST

Well yielded **15** GPM with
a drawdown of **5** ft.
after **1** hours of pumping

WELL DATA

Well Depth 40	Casing Diameter (In.) 2"	Casing Length (Ft.) 35
Type of Casing PVC	Hole Depth 40	Depth to Static Water Level 20'

TYPE OF COMPLETION: (Circle One or More):
~~Natural Development~~ Gravel Packed, Underreamed, Telescoped,
Open Hole, Other

Top of Lap Pipe or Reduction in Casing
NONE FEET IF TELESKOPED OR MORE THAN ONE SCREEN: USE BACK PAGE

LOG DATA

TYPE OF LOG RUN (Circle One):
Electric, Gamma Ray, Density, Sonic, Neutron,
Other (Describe) _____ **(No Log Run.)**

Name of Organization Running Log _____

SCREEN DATA

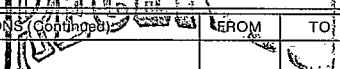
Diameter - Inches 2"	Length - Feet 5'	Slot Size - Inches 8
Screen Type PVC WRAP	Depth to Bottom - Feet 35	

GEOLOGIC DATA (Office Use Only)

Surface Elev.	Geologic Unit	Unit Thickness	Depth to Top
Subs. SWL	Date	Analysis	Aquifer Test

Driller's Remarks

DESCRIPTION OF FORMATIONS ENCOUNTERED	FROM	TO	FORMATIONS (continued)	FROM	TO
TOP SOIL	0	2			
RED CLAY	2	12			
SAND WITH CHAR	12	40			


APR 20 1987
Department of Natural Resources
Bureau of Land & Water Resources

IF MORE SPACE IS NEEDED, USE BACK

If well telescopes please
sketch and show depths.

GROUND LEVEL

SECTION _____

Please indicate well location X.

ADDITIONAL INFORMATION

If more than one screen,
show location of each on sketch.