

MISSISSIPPI DEPARTMENT OF NATURAL RESOURCES

Bureau of Land and Water Resources

P.O. Box 10631

Jackson, Mississippi 39209

WATER WELL DRILLERS LOG

COUNTY WELL LOCATED WAYNE	
WELL NUMBER Φ	CODED
DATE WELL COMPLETED 12/9/88	

PERMIT NUMBER 205
NAME OF DRILLING FIRM CARR'S WELL SER.
BUCKATONNA, MS

NAME & MAILING ADDRESS OF LANDOWNER REYNOLDS CLARK		
606 WAYNE ST.		
WAYNESBORO MS 39367		
WELL LOCATION: SEC	TOWNSHIP	RANGE
2	8	6
DISTANCE	DIRECTION	NEAREST TOWN
5 1/2 Miles	E	WAYNESBORO
OTHER LANDMARK		
WELL PURPOSE: <input checked="" type="checkbox"/> Home Irrigation, <input type="checkbox"/> Municipal, <input type="checkbox"/> Industrial, <input type="checkbox"/> Fish Pond, etc.		

PUMP DATA		
PUMP TYPE (Circle One): Submersible, Turbine, <input checked="" type="radio"/> Jet, <input type="radio"/> Flowing Well, Other (Describe) _____		
POWER TYPE (Circle One): <input checked="" type="radio"/> Electric, <input type="radio"/> Tractor, <input type="radio"/> Diesel, <input type="radio"/> Gasoline, <input type="radio"/> Butane, Other (Describe) Φ H/P 1		
Pump Capacity (GPM) 12	No. of Stages 2	Setting Depth 80 FT.
PUMP TEST		
Well yielded 10 GPM with a drawdown of 5 ft. after 2 hours of pumping		

WELL DATA		
Well Depth 152	Casing Diameter (In.) 2"	Casing Length (Ft.) 136
Type of Casing PUC	Hole Depth 152	Depth to Static Water Level 68
TYPE OF COMPLETION: (Circle One or More): <input checked="" type="checkbox"/> Gravel Packed, <input type="checkbox"/> Underreamed, <input type="checkbox"/> Telescoped, <input checked="" type="checkbox"/> Natural Development, <input type="checkbox"/> Open Hole, <input type="checkbox"/> Other (Describe) _____		
Top of Lap Pipe or Reduction in Casing		
FEET	IF TELESCOPED OR MORE THAN ONE SCREEN: USE BACK PAGE	

LOG DATA	
TYPE OF LOG RUN (Circle One): <input checked="" type="radio"/> Electric, <input type="radio"/> Gamma Ray, <input type="radio"/> Density, <input type="radio"/> Sonic, <input type="radio"/> Neutron, Other (Describe) _____	
Name of Organization Running Log JAN 19 1989	

SCREEN DATA		
Diameter - Inches	Length - Feet	Slot Size - Inches
Screen Type OPEN END	Depth to Bottom - Feet	

GEOLOGIC DATA (Office Use Only)			
Surface Elev. BURTON ROAD	Geologic Unit	Unit Thickness	Depth to Top
Subs. SWL	Date	Analysis	Aquifer Test


Driller's Remarks			

DESCRIPTION OF FORMATIONS ENCOUNTERED	FROM	TO	FORMATIONS (Continued)	FROM	TO
TOP SOIL	0	1			
CLAY + SAND	1	7			
SAND	7	10			
BLUE CLAY	10	20			
GRAY SAND	20	21			
CLAY	21	25			
SAND + CLAY	25	29			
CLAY	29	51			
ROCK STRATOR	51	73			
CLAY	73	126			
ROCK STRATOR	126	152			

IF MORE SPACE IS NEEDED, USE BACK

If well telescopes please
sketch and show depths.

GROUND LEVEL

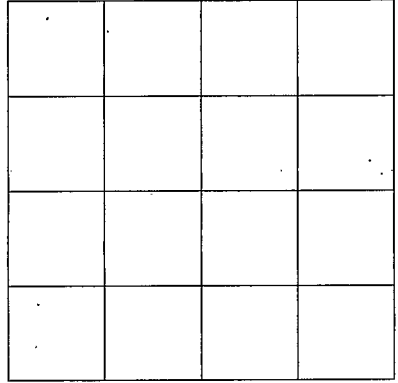

SECTION _____

Please indicate well location X.

ADDITIONAL INFORMATION

If more than one screen,
show location of each on sketch.
