

MISSISSIPPI DEPARTMENT OF ENVIRONMENTAL QUALITY
Bureau of Land and Water Resources

P. O. Box 10631
Jackson, MS 39289-0631
WATER WELL DRILLERS LOG

COUNTY WELL LOCATED .. WAYNE	
WELL NUMBER Φ	CODED
2103	
DATE WELL COMPLETED 8-1-91	

PERMIT NUMBER 0205
NAME OF DRILLING FIRM CARRS well SERV

NAME & MAILING ADDRESS OF LANDOWNER A.D. EZell			
INDUSTRIAS PARK Rd			
WELL LOCATION:	SEC	TOWNSHIP	RANGE
	24	8	6
		N	W
DISTANCE	DIRECTION	NEAREST TOWN	
1/2	South	WAYNE	
OTHER LANDMARK LEFT ON AIR PORT Rd			
WELL PURPOSE: Home, Irrigation, Municipal, Industrial, Fish Pond, etc. Home			

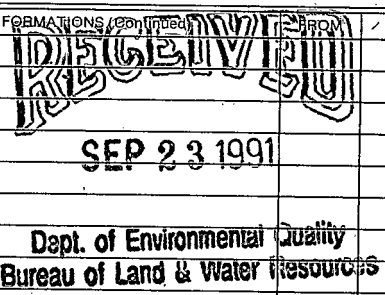
PUMP DATA		
PUMP TYPE (Circle One): Submersible, Turbine, Jet Flowing Well, Other (Describe) _____		
POWER TYPE (Circle One): Electric Tractor, Diesel, Gasoline, Butane, Other (Describe) _____ H/P _____		
Pump Capacity (GPM) 15	No. of Stages 2	Setting Depth 40 FT.
PUMP TEST		
Well yielded 15 GPM with a drawdown of 0 ft. after 1 hours of pumping		

WELL DATA		
Well Depth 80	Casing Diameter (In.) 2	Casing Length (Ft.) 75
Type of Casing PVC	Hole Depth 80	Depth to Static Water Level 20
TYPE OF COMPLETION: (Circle One or More): Gravel Packed, Underreamed, Telescoped, Natural Development, Open Hole, Other (Describe) _____		
Top of Lap Pipe or Reduction in Casing FEET IF TELESKOPED OR MORE THAN ONE SCREEN: USE BACK PAGE		

LOG DATA	
TYPE OF LOG RUN (Circle One): No Log Run, Electric, Gamma Ray, Density, Sonic, Neutron, Other (Describe) _____	
Name of Organization Running Log	

SCREEN DATA		
Diameter - Inches 2	Length - Feet 5	Slot Size - Inches 8
Screen Type PVC WRAPED	Depth to Bottom - Feet 80	

GEOLOGIC DATA (Office Use Only)			
Surface Elev.	Geologic Unit	Unit Thickness	Depth to Top
Subs. SWL	Date	Analysis	Aquifer Test
Driller's Remarks			

DESCRIPTION OF FORMATIONS ENCOUNTERED	FROM	TO	FORMATIONS (continued)	FROM	TO
TOP SOIL	0	1			
Yellow & white clay	1	8			
Coarse white SD	8	19			
Blue clay	19	32			
ROCK	32	32 1/2			
Blue clay	32 1/2	44			
ROCK	44	56			
ROCK STRATIFERS	56	60			
FINE GRAY SD	60	80			

IF MORE SPACE IS NEEDED, USE BACK

If well telescopes please
sketch and show depths.

GROUND LEVEL

SECTION _____

Please indicate well location X.

ADDITIONAL INFORMATION

If more than one screen,
show location of each on sketch.