

WAYNE

MISSISSIPPI  
BOARD OF WATER COMMISSIONERS  
416 North State Street  
Jackson, Mississippi 39201

2-14-78

WATER WELL DRILLERS LOG  
McILWAIN WATER WELL SERVICE

Feb 14

19 78 RT 2 BOX 37

Wayne

date well completed

WAYNESBORO, MISS. 39367

county well located

LANDOWNER:

John Shirley  
Waynesboro

(mailing address)

description of formations encountered

from

to

Red sandy Clay

0 15

Sand

15 25

Clay

25 26

Fine Sand

26 30

Med Sand

30 42

Clay

42 68

Sand & Clay

68 80

Sand

80 90

WELL LOCATION:

sec. 26 T 8 N R. 6 west

4 miles SE of Waynesboro  
(distance) (direction) (nearest town)

WELL PURPOSE:

Home  
(home, irrigation, municipal, industrial)

WELL COMPLETION DATA:

(1) diameter (inches) 2"  
(2) total depth (feet) 90'

(3) static water level (feet) 48' below  
top of ground.

(4) casing PVC 85'  
(material) (depth)

2" if telescope see back.  
(size)

(5) screen 5' 85'  
(length) (depth to top)

2" PVC 008  
(size) (material)

(6) pump 1 10  
(HP) (yield gpm)

220 AC  
(type power)

(7) electric log No  
(yes or no)

(organization running log)

(8) how well bottom plugged


DRILLERS REMARKS:

RECEIVED  
APR 24 1978

MISS. BD. OF WATER COMM

If well telescopes please sketch and show depths.

GROUND LEVEL

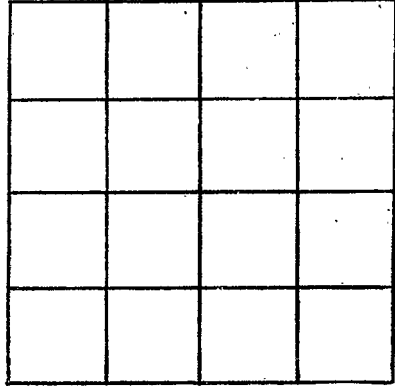

SECTION \_\_\_\_\_

Please indicate well location X.

ADDITIONAL INFORMATION

If more than one screen,  
show locations of each on sketch.