

WAYNE

MISSISSIPPI
BOARD OF WATER COMMISSIONERS
416 North State Street
Jackson, Mississippi 39201

4-15-78

WATER WELL DRILLERS LOG
McILWAIN WATER WELL SERVICE

April 15 1978
date well completed

RT. 2 BOX 32
WAYNESBORO, MISS. 39367

Wayne
county well located

LANDOWNER:

Yemlinson Homes Inc.
Waynesboro Miss.
(mailing address)

description of formations encountered

from to

Red Clay	0	10
Max. Clay	10	14
Sand	14	31

WELL LOCATION:

sec. 17 T. 8 N R. 6 E
2 miles SE of Waynesboro
(distance) (direction) (nearest town)

WELL PURPOSE: Home
(home, irrigation, municipal, industrial)

WELL COMPLETION DATA:

- (1) diameter (inches) 2"
- (2) total depth (feet) 31'
- (3) static water level (feet) 12' below top of ground.
- (4) casing PVC 26'
(material) (depth)
2" (size) if telescope see back.
- (5) screen 5' 26'
(length) (depth to top)
2" PVC 1008
(size) (material)
- (6) pump 1/2 17
(HP) (yield gpm)
220 AC
(type power)
- (7) electric log No
(yes or no)

(organization running log)

(8) how well bottom plugged


DRILLERS REMARKS:

RECEIVED
APR 24 1978

MISS. BD. OF WATER COMM.

If well telescopes please sketch and show depths.

GROUND LEVEL

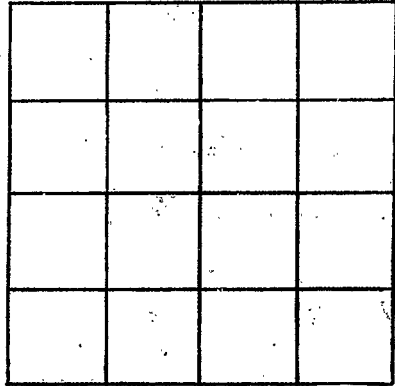

SECTION _____

Please indicate well location X.

ADDITIONAL INFORMATION

If more than one screen,
show locations of each on sketch.