

WAYNE

2115  
D3012

7-1-78

MISSISSIPPI  
BOARD OF WATER COMMISSIONERS  
416 North State Street  
Jackson, Mississippi 39201

WATER WELL DRILLERS LOG

July 1 78  
date well completed

NO. 11 WAIN WATER WELL SERVICE  
RT. 2. <sup>firm name</sup> BOX 37

WAYNE  
county well located

LANDOWNER:

JAMES JORDAN

Waynesboro Ms  
(mailing address)

WAYNESBORO

MISS. 39367  
description of formations encountered

from

to

SAND (Red)

0

5

FINE SAND

5

10

CLAY

10

13

SAND

13

35

WELL LOCATION:

sec. 33 T. 8 N R. 6 E

6 miles S of Wayboro  
(distance) (direction) (nearest town)

WELL PURPOSE:

Home  
(home, irrigation, municipal, industrial)


WELL COMPLETION DATA:

- (1) diameter (inches) 2"
- (2) total depth (feet) 35'
- (3) static water level (feet) 10' below  
top of ground.
- (4) casing PVC 30'  
(material) (depth)  
2" if telescope see back.  
(size)
- (5) screen 5' 30'  
(length) (depth to top)  
2" PVC  
(size) (material)
- (6) pump 1 10  
(HP) (yield gpm)  
220 AC  
(type power)
- (7) electric log No  
(yes or no)

(organization running log)

(8) how well bottom plugged

DRILLERS REMARKS:

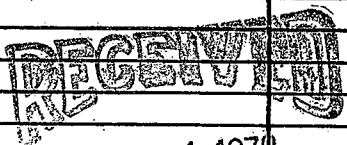


AUG 11 1978

BO. OF WATER COMMISSIONERS

If well telescopes please  
sketch and show depths.

GROUND LEVEL

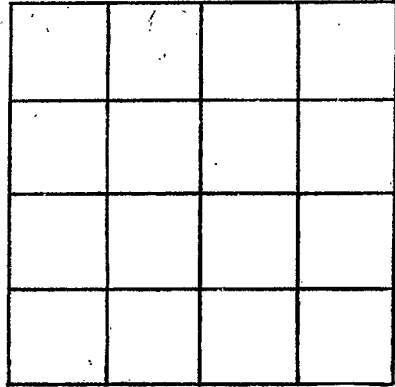

SECTION \_\_\_\_\_

Please indicate well location X.

ADDITIONAL INFORMATION

If more than one screen,  
show locations of each on sketch.