

P 8

11-24-63

WATER WELL DRILLERS LOG

Date Nov 24, 1963, Driller Porter Drilling & Sup
McCarly Taylor County Wayne
(Name)

(1) Owner of Land McCarly Taylor
(Name)
Rt 1 Buckatanna
(Address)

(2) Location: SE 1/4, NE 1/4, Sec 16 T8 R5
10 miles east of Waynesboro
(distance) (direction) (Nearest Town)

(3) Topography: hilly
(Hilly) (Flat) (Level)

(4) Purpose of Well: domestic
(Domestic Irrigation
 Municipal, Industrial, Other)

Description & Color of Materials Sand, Clay, Red Clay, Shell, etc.	Thick- ness Feet	Depth Feet
red clay	10	10
chalk	8	18
sand	27	35
sand & chalk	13	48
rock	1	49
chalk	38	87
rock	1	88
sand	31	119

Information upon completion of well:

(1) Diameter 2" inches.

(2) Total Depth 119' feet.

(3) Water Level 97' feet below top of ground.

(4) Cased to 115', Size 2"


(5) Screen: Size 1 1/4", Length 5'

(6) Were any formations sealed against pollution?
Johnson S.S.
 yes, no.

If YES depth of formation _____

Why _____

Drillers Remarks: _____

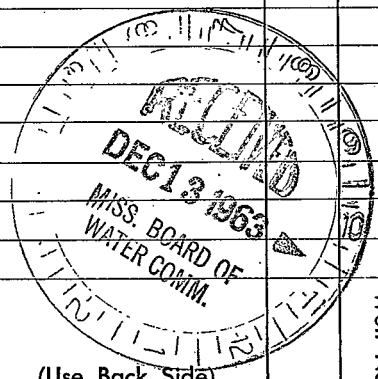

Well No. _____

(Use Back Side)

