

P9

12-26-63

WATER WELL DRILLERS LOG

Date: Dec 26, 1963, Driller: Porter Drilling & Supply Co County Wayne  
 (Name)

(1) Owner of Land: Vernon Taylor  
 (Name)  
Rt 1 Buckatanna  
 (Address)  
 (2) Location: NE 1/4, SW 1/4, Sec. 27 T8R5  
12 miles SE of Waynesboro  
 (distance) (direction) (Nearest Town)  
 (3) Topography: Hilly  
 (Hilly) (Flat) (Level)  
 (4) Purpose of Well: domestic  
 (Domestic Irrigation  
 Municipal, Industrial, Other)


Description & Color of Materials Sand, Clay, Red Clay, Shell, etc.	Thick- ness Feet	Depth Feet
<u>sandy clay</u>	<u>4</u>	<u>4</u>
<u>hard yellow shale</u>	<u>12</u>	<u>16</u>
<u>stuck</u>	<u>8</u>	<u>24</u>
<u>blue chalk</u>	<u>19</u>	<u>43</u>
<u>thin rock</u>		<u>43</u>
<u>sand &amp; chalk</u>	<u>12</u>	<u>55</u>
<u>sand - med.</u>	<u>11</u>	<u>66</u>
<u>course sand &amp; pea gravel</u>	<u>6</u>	<u>72</u>
<u>stayed white shell</u>		
<u>in sand</u>		

Information upon completion of well:

(1) Diameter 2" inches.  
 (2) Total Depth 72' feet.  
 (3) Water Level 23' feet below top of ground.  
 (4) Cased to 63, Size 2"  
 (5) Screen: Size 1 1/4, Length 5'  
Johnson S.S  
 (6) Were any formations sealed against pollution?  
 \_\_\_\_\_ yes, X no.

If YES depth of formation \_\_\_\_\_  
 Why \_\_\_\_\_

Drillers Remarks: \_\_\_\_\_

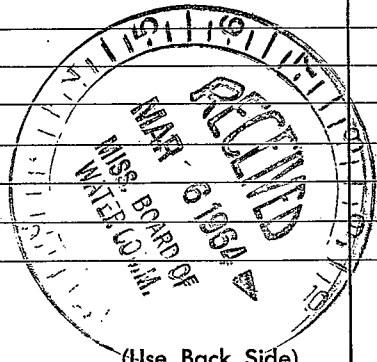

(Use Back Side)

Well No.

