

WAYNE  
 P10  
 3-4-66

MISSISSIPPI BOARD OF WATER COMMISSIONERS

WATER WELL DRILLERS LOG

Date: March 4, 1966, Driller: Porter Drilling & Supply Co. Wayne  
Denham-Bucatunna Rd. (Name)


(1) Owner of Land: Edwin Porter  
 (Name)  
Box 2 Magneshoro, Miss  
 (Address)  
 (2) Location: NE 1/4, SW 1/4, Sec 30 T8R6E  
8 miles S.E. of Magneshoro  
 (distance) (direction) (Nearest Town)  
 (3) Topography: flat  
 (Hilly) (Flat) (Level)  
 (4) Purpose of Well: domestic  
 (Domestic Irrigation  
 Municipal, Industrial, Other)

Description & Color of Materials Sand, Clay, Red Clay, Shell, etc.	Thick- ness Feet	Depth Feet
Clay	5	5
Chalk	5	10
rock	60	70
Chalk blue	50	122
rock strata	22	144
blue chalk	76	220
hard rock	24	244
white chalk & layers	22	266
of hard shell	10	276
white chalk & soft	1	277
shell	2	279
rock	71	350
Chalk & thin rock		350
blue chalk	6	356
thin rock	1	357
blue chalk	48	405
soft rock		405
blue chalk	3 1/2	408 1/2
thin rock	22 1/2	431
blue chalk		431
soft wood layer & chalk	11	442
thin hard rock		
clean fine sand		
stayed while		
still in sand		

Information upon completion of well:

(1) Diameter 2" inches.  
 (2) Total Depth 442 feet.  
 (3) Water Level flowing feet below top of ground. 20 gal. per min.  
 (4) Cased to 431, Size 2"  
 (5) Screen: Size none, Length \_\_\_\_\_  
 (6) Were any formations sealed against pollution?  
3 1/2" brush sweep into rock  
shell funnel above brushing  
 \_\_\_\_\_ yes, X no.

If YES depth of formation \_\_\_\_\_  
 Why \_\_\_\_\_  
 Drillers Remarks: \_\_\_\_\_

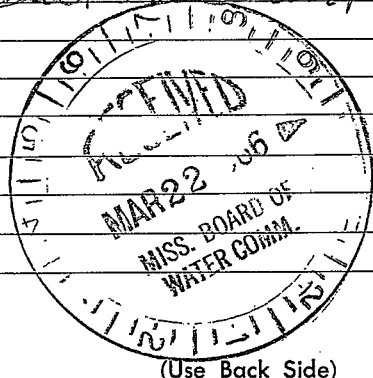

Well No.

