

MISSISSIPPI BOARD OF WATER COMMISSIONERS

WAYNE

P 13

10-10-61

WATER WELL DRILLERS LOG

P?

Date: Oct 10, 1961, Driller: D. N. Porter for County Wayne
 (Name)

(1) Owner of Land: Bobby Napier
 (Name)
Rt 1 Buckatanna
 (Address)
 (2) Location: NW 1/4, NE 1/4, Sec. 3 T. 7 R. 5
7 miles NE of Buckatanna
 (distance) (direction) (Nearest Town)
 (3) Topography: hilly
 (Hilly) (Flat) (Level)
 (4) Purpose of Well: domestic
 (Domestic Irrigation
 Municipal, Industrial, Other)

Description & Color of Materials Sand, Clay, Red Clay, Shell, etc.	Thick- ness Feet	Depth Feet
<u>Clay</u>	<u>10'</u>	<u>10'</u>
<u>sand</u>	<u>17</u>	<u>27'</u>
<u>Chalk</u>	<u>53</u>	<u>80</u>
<u>sand</u>	<u>10</u>	<u>90</u>
<u>stopped while still in sand</u>		


Information upon completion of well:

(1) Diameter 2' inches.
 (2) Total Depth 90' feet.
 (3) Water Level 54' feet below top of ground.
 (4) Cased to 84', Size 2"
 (5) Screen: Size 1 1/4", Length 6'
 (6) Were any formations sealed against pollution?
 _____ yes, X no.

If YES depth of formation _____

Why _____

Drillers Remarks: _____

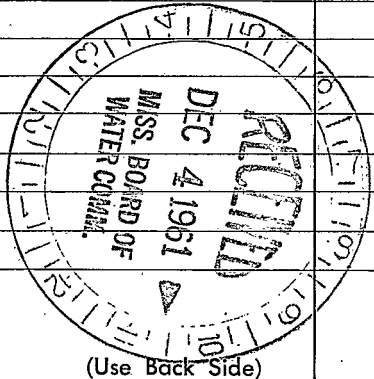

Well No.

