

Wayne
 P15
 9-67

MISSISSIPPI
 BOARD OF WATER COMMISSIONERS
 416 North State Street
 Jackson, Mississippi 39201

WATER WELL DRILLERS LOG

Sept 16 1967 Porter Drilling & Pump Wayne
 date well completed firm name county well located

LANDOWNER: Alley McElwan

description of formations encountered	depth	
	from	to

Rt 2 Waynesboro Miss
 (mailing address)

red sand	0	15
red chals	15	18
blue chals	18	37
rock strata	37	58
blue chals	58	110
thin rock		110
blue chals	110	112
Nicksburg honeycom	112	132
white chals	132	140


WELL LOCATION:
 sec. 6 T. 8 N. R. 5 E.
8 miles east of Waynesboro
 (distance) (direction) (nearest town)

WELL PURPOSE: home
 (home, irrigation, municipal, industrial)

WELL COMPLETION DATA:


- (1) diameter (inches) 2"
- (2) total depth (feet) 140'
- (3) static water level (feet) 96' below above top of ground.
- (4) casing steel, 112',
 (material) (depth)
2"
 (size) if telescope see back.
- (5) screen none used
 (length) (depth to top)
 (size) (material)
- (6) pump 2 8
 (HP) (yield gpm)
elec
 (type power)
- (7) electric log yes
 (yes or no)
 (organization running log)
- (8) how well bottom plugged

DRILLERS REMARKS:

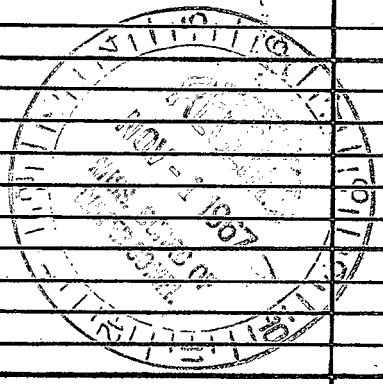

If well telescopes please sketch and show depths.

GROUND LEVEL

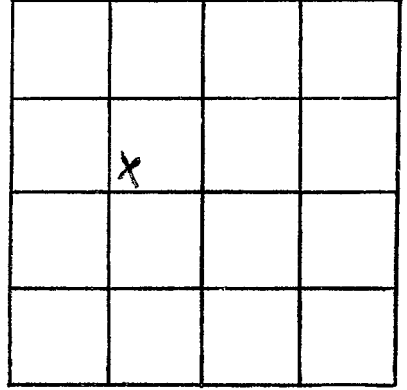

SECTION 6

Please indicate well location X.

ADDITIONAL INFORMATION

If more than one screen, show locations of each on sketch.