

WAYNE

MISSISSIPPI BOARD OF WATER COMMISSIONERS

P16

8-31-65

WATER WELL DRILLERS LOG

Date: Aug 31, 1965, Driller: Porter Drilling Co. County: Wayne (Name)

| (1) Owner of Land:  | Description & Color of Materials<br>Sand, Clay, Red Clay, Shell, etc. | Thick-<br>ness<br>Feet | Depth<br>Feet |
|---|---|------------------------|---------------|
| Elizabeth M. Carr<br>(Name)   | red clay  | 10                     | 10            |
| Rt 1 Buckatanna<br>(Address)  | fine sand   | 38                     | 48            |
| SE 1/4, NW 1/4, Sec. 9 T8R5<br>(Location)   | course sand   | 18                     | 66            |
| 9 miles east of Napoleon<br>(distance) (direction) (Nearest Town)                   | bottom sand   |                        |               |
| Hilly<br>(Topography) (Hilly) (Flat) (Level)  | lost chert and would<br>not produce water                             |                        |               |
| Domestic<br>(Purpose of Well) (Domestic Irrigation<br>Municipal, Industrial, Other) | 2" shell found above<br>screen  |                        |               |


Information upon completion of well:

- (1) Diameter 2" inches. Copper
- (2) Total Depth 58' feet.
- (3) Water Level 41' feet below top of ground.
- (4) Cased to 52', Size 2"
- (5) Screen: Size 1 1/4", Length 5'  
Johnson S.S. 10 mesh
- (6) Were any formations sealed against pollution?  
yes, X no.

If YES depth of formation \_\_\_\_\_

Why \_\_\_\_\_

Drillers Remarks: \_\_\_\_\_

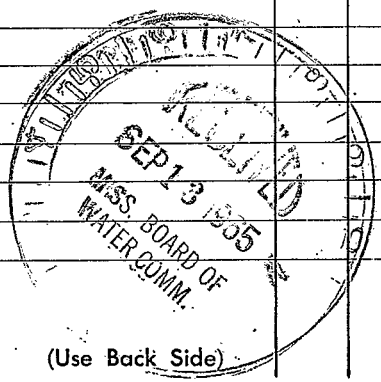

Well No.

