

**MISSISSIPPI
BOARD OF WATER COMMISSIONERS**
416 North State Street
Jackson, Mississippi 39201

WATER WELL DRILLERS LOG

Wayne
P19
9-67

Sept 25 1967 Boyer Drilling Co Wayne
date well completed firm name county well located

LANDOWNER: Heamon Taylor

description of formations encountered

from to

211 Buckatanna, Miss
(mailing address)

<u>red clay</u>	<u>0</u>	<u>13</u>
<u>blue chert</u>	<u>13</u>	<u>32</u>
<u>red chert</u>	<u>32</u>	<u>37</u>
<u>thin rock</u>		<u>37</u>
<u>chert & sand</u>	<u>37</u>	<u>42</u>
<u>loose med coarse sand</u>	<u>42</u>	<u>68</u>
<u>chert</u>	<u>68</u>	<u>69</u>

WELL LOCATION:

sec 27 T 8 N R 5 E
S W
12 miles east of Waynesboro
(distance) (direction) (nearest town)

WELL PURPOSE: home
(home, irrigation, municipal, industrial)


WELL COMPLETION DATA:

- (1) diameter (inches) 2"
- (2) total depth (feet) 69'
- (3) static water level (feet) 14 below above top of ground.
- (4) casing steel, 63'
(material) (depth)
2'
(size) If telescope see back.
- (5) screen 5, 63
(length) (depth to top)
1/4, steel SS.
(size) (material)
- (6) pump 3/4 10
(HP) (yield gpm)
elec.
(type power)
- (7) electric log no
(yes or no)

(organization running log)


(8) how well bottom plugged

DRILLERS REMARKS:

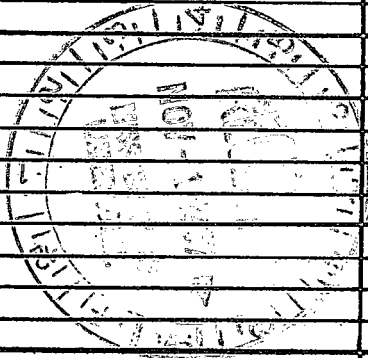

If well telescopes please sketch and show depths.

GROUND LEVEL

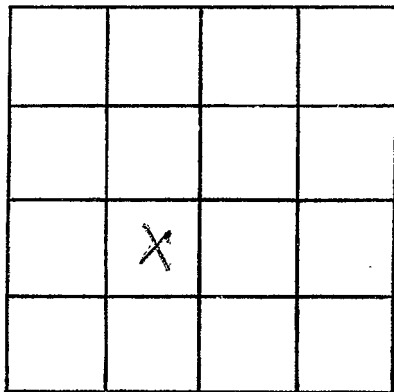

SECTION 27

Please indicate well location X.

ADDITIONAL INFORMATION

If more than one screen,
show locations of each on sketch.