

WAYNE MISSISSIPPI BOARD OF WATER COMMISSIONERS

P21

8-5-65

WATER WELL DRILLERS LOG

Date Aug 5, 1965, Driller Porter Drilling Co County Wayne  
(Name)


(1) Owner of Land: Mr Mathie Pettis  
(Name)  
Rt 1 Buckatanna, Miss  
(Address)  
(2) Location: NW 1/4, NE 1/4, Sec. 32 T. 8 R. 5  
6 miles west of Buckatanna  
(distance) (direction) (Nearest Town)  
(3) Topography: hilly  
(Hilly) (Flat) (Level)  
(4) Purpose of Well: domestic  
(Domestic Irrigation  
Municipal, Industrial, Other)

Description & Color of Materials Sand, Clay, Red Clay, Shell, etc.	Thick- ness Feet	Depth Feet
clay & sand	18	18
chalk	24	42
med clean sand	12	54
sand & chalk	8	62
clean med sand	6	68
stagnant white steel in sand		

Information upon completion of well:

(1) Diameter 2' inches.  
(2) Total Depth 68' feet.  
(3) Water Level 44' feet below top of ground.  
(4) Cased to 63', Size 2"  
(5) Screen: Size 1 1/4", Length 5'  
8 slot Johnson S.S.  
(6) Were any formations sealed against pollution?  
no

If YES depth of formation \_\_\_\_\_  
Why \_\_\_\_\_  
Drillers Remarks: \_\_\_\_\_

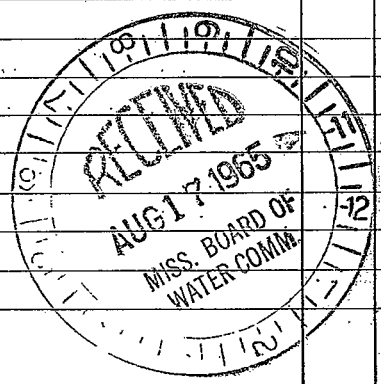

(Use Back Side)

Well No.

[The page contains extremely faint and illegible text, likely bleed-through from the reverse side of the document. No specific words or phrases can be discerned.]