

Wayne  
P22  
12-66

MISSISSIPPI  
BOARD OF WATER COMMISSIONERS  
416 North State Street  
Jackson, Mississippi 39201

WATER WELL DRILLERS LOG

Dec 20, 19 66 Porter Drilling Co. Wayne  
date well completed firm name county well located

LANDOWNER: Gene Roan

Box 1 Buckatanna  
(mailing address)


WELL LOCATION:  
sec 33 T 8 N R 5 E  
S W  
10 miles SE of Hazardous  
(distance) (direction) (nearest town)

WELL PURPOSE: home  
(home, irrigation, municipal, industrial)

WELL COMPLETION DATA:

- (1) diameter (inches) 2"
- (2) total depth (feet) 146'
- (3) static water level (feet) 99' below top of ground.
- (4) casing steel, 141 1/2' (depth)  
2" (size) if telescope see back.
- (5) screen 5' (length), 141' (depth to top)  
1 1/4" (size), Johnson S.S. 20 mesh (material)
- (6) pump 2 (HP), 7 (yield gpm)  
elec. (type power)
- (7) electric log no (yes or no)  
(organization running log)
- (8) how well bottom plugged  
1 1/4" plug

description of formations encountered	from	to
red clay	0	10
fine sand	10	25
coarse sand	25	33
white chalk	33	46
fine sand	46	49
chalk	49	130
thin rock		130
chaly sand	130	134
med coarse sand	134	146
stagnant white silt in sand		

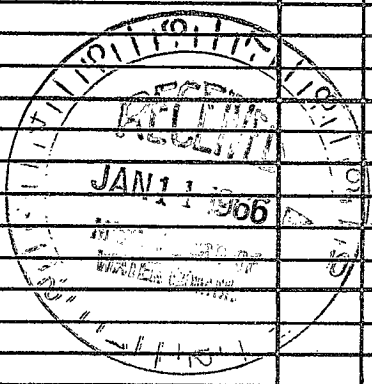

DRILLERS REMARKS:

If well telescopes please sketch and show depths.


GROUND LEVEL

14 1/2" ca



5 1/4" screen

set in with packer

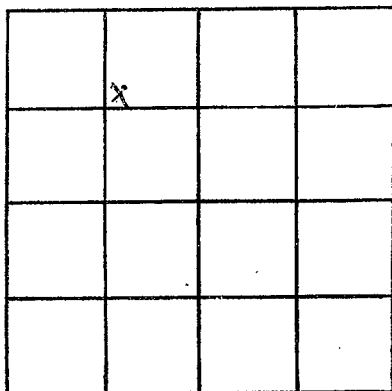

SECTION 33

Please indicate well location X.

ADDITIONAL INFORMATION

If more than one screen, show locations of each on sketch.