

WAYNE MISSISSIPPI BOARD OF WATER COMMISSIONERS

P23

2-5-66

WATER WELL DRILLERS LOG


Date: Feb 5, 1966, Driller: Porter Drilling & Log County Wayne
 (Name)

(1) Owner of Land:	Description & Color of Materials Sand, Clay, Red Clay, Shell, etc.	Thick- ness Feet	Depth Feet
<u>Jim Bugh</u> (Name)	<u>red clay</u>	<u>12</u>	<u>12</u>
<u>Pt 1 Magnolia, Miss</u> (Address)	<u>sand</u>	<u>23</u>	<u>3.5</u>
(2) Location: <u>SE 1/4, NW 1/4, Sec 35 T9 R8</u>	<u>chalk</u>	<u>38</u>	<u>73</u>
<u>9</u> miles <u>east</u> of <u>Magnolia</u> (distance) (direction) (Nearest Town)	<u>fine sand & chalk</u>	<u>40</u>	<u>113</u>
(3) Topography: <u>Hilly</u> (Hilly) (Flat) (Level)	<u>hard pan gravel</u>	<u>3</u>	<u>116</u>
(4) Purpose of Well: <u>domestic</u> (Domestic Irrigation Municipal, Industrial, Other)	<u>course sand & peb</u>	<u>7</u>	<u>123</u>
	<u>gravel red</u>	<u>9</u>	<u>132</u>
	<u>course red sand</u>	<u>7</u>	<u>139</u>
	<u>red sand slightly</u>		
	<u>red</u>		
	<u>stopped while still</u>		
	<u>in sand</u>		

Information upon completion of well:

- (1) Diameter 2" inches.
- (2) Total Depth 139' feet.
- (3) Water Level 89' feet below top of ground.
- (4) Cased to 126', Size 2"
- (5) Screen: Size 1 1/4", Length 5'
6 slot Johnson S.S. with 9' 1 1/4" lap
- (6) Were any formations sealed against pollution?
 yes, no.

If YES depth of formation _____
 Why _____
 Drillers Remarks: _____

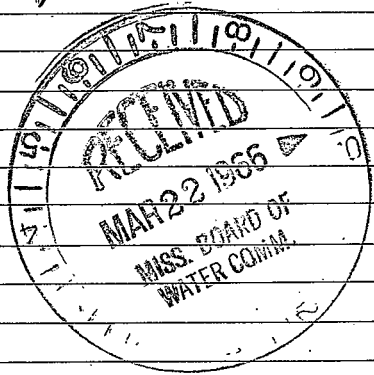

(Use Back Side)

Well No.

