

WAYNE
P 25
3-68

MISSISSIPPI
BOARD OF WATER COMMISSIONERS
416 North State Street
Jackson, Mississippi 39201

WATER WELL DRILLERS LOG

March 25, 1968 Porter Drilling, Inc. Wayne
date well completed firm name county well located

LANDOWNER: B. J. Kleton
BL4
Waynesboro Miss.
(mailing address)

description of formations encountered	from	to
<u>red clay</u>	<u>0</u>	<u>12</u>
<u>sand</u>	<u>12</u>	<u>20</u>
<u>Chalk</u>	<u>20</u>	<u>26</u>
<u>sand</u>	<u>26</u>	<u>50</u>
<u>Chalk & sand</u>	<u>50</u>	<u>52</u>
<u>sand</u>	<u>52</u>	<u>60</u>
<u>stop on chalk</u>		

WELL LOCATION:
sec. 7 T. 8 N. R. 5 E. W
6 miles east of Waynesboro
(distance) (direction) (nearest town)

WELL PURPOSE: home
(home, irrigation, municipal, industrial)

WELL COMPLETION DATA:

(1) diameter (inches) 2"

(2) total depth (feet) 60'

(3) static water level (feet) 48 below above top of ground.

(4) casing steel 54 1/2'
(material) (depth)
2" If telescope see back.
(size)

(5) screen 5' 55'
(length) (depth to top)
1/4" Galat Johnson S.S.
(size) (material)

(6) pump 1 3
(HP) (yield gpm)
elec
(type power)

(7) electric log no
(yes or no)

(organization running log)

(8) how well bottom plugged flush joint


DRILLERS REMARKS:

APR 26 1968

MISS. BD. OF
WATER COM.

If well telescopes please sketch and show depths.

GROUND LEVEL

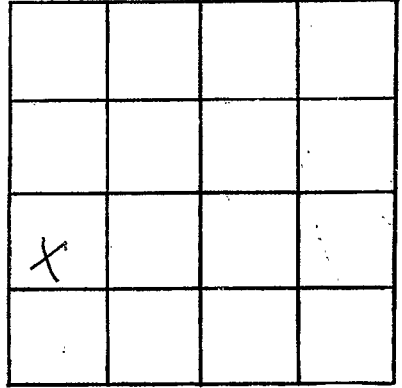

SECTION 2

Please indicate well location X.

ADDITIONAL INFORMATION

If more than one screen,
show locations of each on sketch.