

MISSISSIPPI
BOARD OF WATER COMMISSIONERS
416 North State Street
Jackson, Mississippi 39201

CODED

CODED

WATER WELL DRILLERS LOG

Wayne
P27
8-68

8/22 date well completed 19 68 CARBS WATER WELL SERVICE firm name WAYNE county well located

LANDOWNER: Eckie Reynolds

description of formations encountered	from	to
Top soil	0	4
Red sandy clay	4	9
White clay	9	20
Fine white sand	20	40
POWDER SAND ROCK	40	41
White sandy clay	41	44
Coarse white sand	44	67

R21 BUCATUNNA MISS
(mailing address)

WELL LOCATION:
sec 36 T 8 (N) R 6 (E)
11 miles ESE of Waynesboro
(distance) (direction) (nearest town)


WELL PURPOSE: Home
(home, irrigation, municipal, industrial)

WELL COMPLETION DATA:

- (1) diameter (inches) 4" x 2"
- (2) total depth (feet) 67
- (3) static water level (feet) 12 ^{below}/_{above} top of ground.
- (4) casing Galv, 63'
(material) (depth)
____ if telescope see back.
(size)
- (5) screen 4', 63'
(length) (depth to top)
2", Stainless steel
(size) (material)
- (6) pump 3/4, 8
(HP) (yield gpm)
Elect
(type power)
- (7) electric log No
(yes or no)
____ (organization running log)


(8) how well bottom plugged B.W.V.
2"

DRILLERS REMARKS:

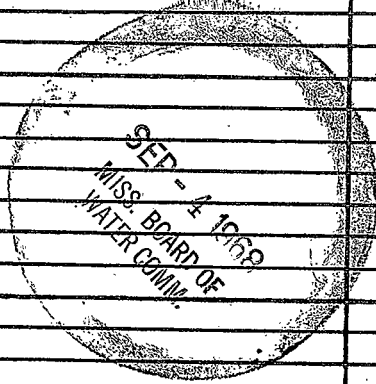

If well telescopes please
sketch and show depths.

GROUND LEVEL

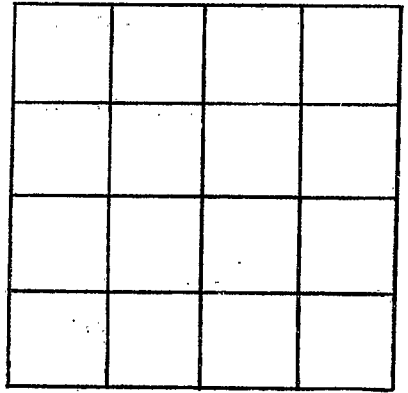

SECTION _____

Please indicate well location X.

ADDITIONAL INFORMATION

If more than one screen,
show locations of each on sketch.