

Wayne
P28
5-30-69

MISSISSIPPI
BOARD OF WATER COMMISSIONERS
416 North State Street
Jackson, Mississippi 39201

CODED

WATER WELL DRILLERS LOG

May 30 1969 Doyle Drilling Wayne
date well completed firm name county well located

LANDOWNER Alice West
Rt 1 Buckatanna
Miss
(mailing address)

description of formations encountered	from	to
rest clay	0	9
sand & chalk	9	23
coarse sand & chalk	23	33
red sand & chalk	33	41

WELL LOCATION:
sec. 10 T 80 N R 5 E
S W
10 miles east of Waynesboro
(distance) (direction) (nearest town)

stop on chalk

WELL PURPOSE: home
(home, irrigation, municipal, industrial)

6' 1 1/4" 60 gm. S.S. with

WELL COMPLETION DATA:

- (1) diameter (inches) 2"
- (2) total depth (feet) 41
- (3) static water level (feet) 14 below top of ground.
- (4) casing steel 35'
(material) (depth)
2" if telescope see back.
(size)
- (5) screen 6' 35'
(length) (depth to top)
1 1/4" 60 gm. S.S.
(size) (material)
- (6) pump 3/4 6
(HP) (yield gpm)
elec.
(type power)
- (7) electric log no
(yes or no)

1' 1 1/4" log bit in with
placker
21' 1 1/4" drop pipe

(organization running log)

MAY 3 1969


(8) how well bottom plugged
flush joint

MISS. BD. OF
WATER COMMISSIONERS

DRILLERS REMARKS:

If well telescopes please sketch and show depths.

GROUND LEVEL

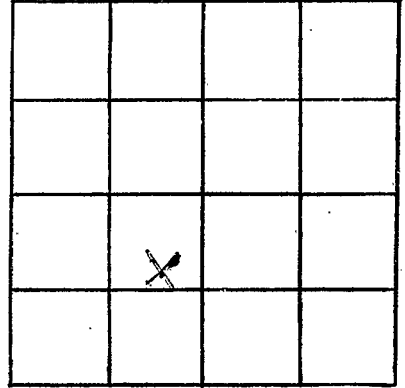

SECTION 10

Please indicate well location X.

ADDITIONAL INFORMATION

If more than one screen,
show locations of each on sketch.