

Wayne  
P 29  
3-4-70

MISSISSIPPI  
BOARD OF WATER COMMISSIONERS  
416 North State Street  
Jackson, Mississippi 39201

WATER WELL DRILLERS LOG

March 4 1970 date well completed  
Garber Drilling firm name  
Wayne county well located

LANDOWNER: J.C. Mc Neal

description of formations encountered

from to

At 2 Haynesboro Miss (mailing address)

rest clay	0	10
sand	10	22
chalk	22	37
rock strata	37	60
blue chalk	60	112
Wichaburg rock	112	135

WELL LOCATION:

sec. 6 T. 80 S. R. 5  
8 miles east Haynesboro of (nearest town)

WELL PURPOSE: home (home, irrigation, municipal, industrial)

WELL COMPLETION DATA:

- (1) diameter (inches) 2'
- (2) total depth (feet) 135'
- (3) static water level (feet) 91' below top of ground
- (4) casing steel (material) 113' (depth)  
2" (size) if telescope see back.
- (5) screen none used (length)          (depth to top)  
         (size)          (material)
- (6) pump 1 1/2 (HP) 10 (yield gpm)  
elec. (type power)
- (7) electric log no (yes or no)

105' 1 1/4' drop pipe  
casing sealed with 5/8" baling

COPY

(organization running log)


(8) how well bottom plugged open

MAR 13 1970

DRILLERS REMARKS:

If well telescopes please sketch and show depths.

GROUND LEVEL

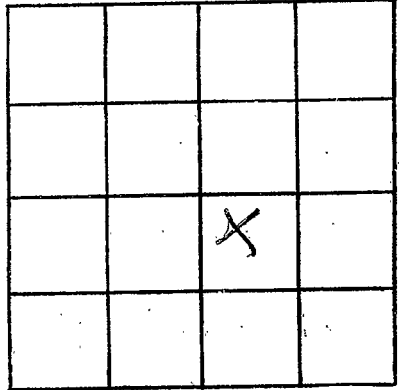

SECTION 16

Please indicate well location X.

ADDITIONAL INFORMATION

If more than one screen,  
show locations of each on sketch.