

MISSISSIPPI
BOARD OF WATER COMMISSIONERS
416 North State Street
Jackson, Mississippi 39201

CODED

WATER WELL DRILLERS LOG

Wayne
P 31
7-17-70

July 17 1970 date well completed
Porter Drilling Corp firm name
Wayne county well located

LANDOWNER: Woodrow
Hollinghead
Rt 2 Magneshoro Miss
(mailing address)

WELL LOCATION:
sec. 10 T 8 N R 5 E
S W
10 miles east of Magneshoro
(distance) (direction) (nearest town)

WELL PURPOSE: home
(home, irrigation, municipal, industrial)

WELL COMPLETION DATA:
(1) diameter (inches) 2"
(2) total depth (feet) 64
(3) static water level (feet) 35 below top of ground.
(4) casing steel 57 1/2 (material) (depth)
2" (size) if telescope see back.
(5) screen 5' 59' (length) (depth to top)
1 1/4" (size) (material) ballot S.S.
(6) pump 1 12 (HP) (yield gpm)
elec (type power)
(7) electric log no (yes or no)
(organization running log)
(8) has well bottom plugged
flush down

description of formations encountered	from	to
red clay	0	3
Chalk	3	35
thin, soft rock		
Chalk & sand	35	49
course sand	49	64
shaly white shell		
int sand		
5' 1/4" ballot S.S.		
with 2' 1/4" log hole		
in with packer.		
42' 1/4" drop pipe		


CODED

DRILLERS REMARKS:

AUG 11 1970

If well telescopes please sketch and show depths.

GROUND LEVEL

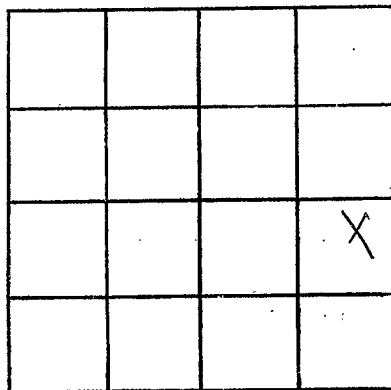

SECTION 10

Please indicate well location X.

ADDITIONAL INFORMATION

If more than one screen,
show locations of each on sketch.