

WAYNE WATER WELL DRILLERS LOG

CODED

Date: April 23, 1963, Driller: Reepes Drilling Co County Wayne
 4-63 134 157 (Name)

(1) Owner of Land: Harley Mc Rae
 (Name)
 (Address)
 (2) Location: 1/4, 1/4, Sec. 6 T 8 R 5
6 miles E of Waynesboro
 (distance) (direction) (Nearest Town)
 (3) Topography: Hilly
 (Hilly) (Flat) (Level)
 (4) Purpose of Well: Chicken Farm
 (Domestic Irrigation
 Municipal, Industrial, Other)


Description & Color of Materials Sand, Clay, Red Clay, Shell, etc.	Thick- ness Feet	Depth Feet
<u>Yellow Sandy Clay</u>	<u>12</u>	<u>12</u>
<u>Yellow Sand</u>	<u>6</u>	<u>18</u>
<u>Blue Clay</u>	<u>18</u>	<u>36</u>
<u>Blue clay & lime streaks</u>	<u>9</u>	<u>45</u>
<u>Lime & limestone</u>	<u>25</u>	<u>70</u>
<u>Gray shale</u>	<u>52</u>	<u>122</u>
<u>lime & limestone</u>	<u>53</u>	<u>175</u>
<u>Gray gummy shale</u>	<u>98</u>	<u>273</u>
<u>Green limy shale</u>		
<u>& limestone</u>	<u>61</u>	<u>334</u>
<u>white sand</u>	<u>12</u>	<u>346</u>

Information upon completion of well:

(1) Diameter 2" inches.
 (2) Total Depth 346 feet.
 (3) Water Level 70 feet below top of ground.
 (4) Cased to 340, Size 2"
 (5) Screen: Size 2", Length 4'
 (6) Were any formations sealed against pollution?
 _____ yes, _____ no.

If YES depth of formation _____
 Why _____
 Drillers Remarks: _____

CODED

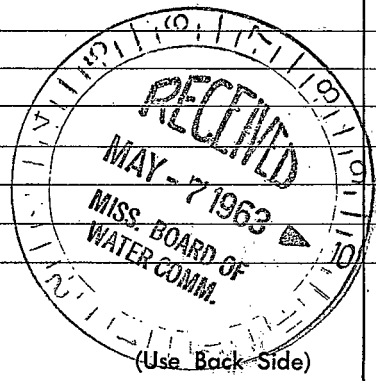

Well No.

...the ...

...the ...

