

WAYNE  
P-34  
8-16-71

MISSISSIPPI  
BOARD OF WATER COMMISSIONERS  
416 North State Street  
Jackson, Mississippi 39201

**CODED**

WATER WELL DRILLERS LOG

Aug 16 1971 Porter Drilling Co. Wayne  
date well completed firm name county well located

LANDOWNER: Nernon Taylor  
At 1 Buckhaterma, Miss.  
(mailing address)

WELL LOCATION:  
sec 27 T 8 N R 5 E  
S W  
9 miles S.E. of Sturgis, Miss.  
(distance) (direction) (nearest town)

WELL PURPOSE: Home  
(home, irrigation, municipal, industrial)

- WELL COMPLETION DATA:
- diameter (inches) 2"
  - total depth (feet) 79'
  - static water level (feet) 31' (below/above top of ground)
  - casing steel 73' (material) (depth)  
2" (size) if telescope see back.
  - screen 5' 74' (length) (depth to top)  
1 1/2" (size) zabk. S.S. (material)
  - pump 1 (HP) 45 (yield gpm)  
elec (type power)
  - electric log yes (yes or no)
- (organization running log)
- (8) how well bottom plugged plugged

description of formations encountered	from	to
<u>clay &amp; chalk</u>	<u>0</u>	<u>30</u>
<u>blue chalk</u>	<u>30</u>	<u>57</u>
<u>slim rock</u>		<u>57</u>
<u>chalk</u>	<u>57</u>	<u>60</u>
<u>house sand</u>	<u>60</u>	<u>70</u>
<u>fine sand</u>	<u>70</u>	<u>75</u>
<u>hard iron gravel</u>	<u>75</u>	<u>79</u>
<u>small white</u>		
<u>stuck in sand but</u>		
<u>gotten faster.</u>		
<u>5' 1/4" zalc. S.S.</u>		
<u>with 2' 1/4" log bit</u>		
<u>in with packer</u>		
<u>1/2' 1/4" drop pipe</u>		

**CODED**


AUG 24 1971

DRILLERS REMARKS:

MISS. BD. OF  
WATER COMM.

If well telescopes please sketch and show depths.

GROUND LEVEL

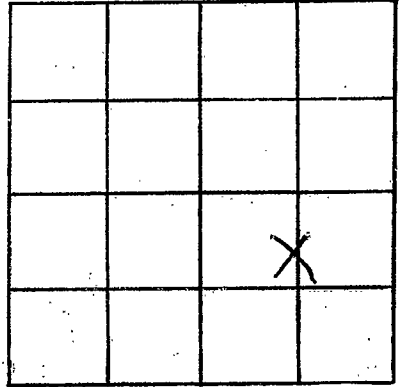

SECTION 27

Please indicate well location X.

ADDITIONAL INFORMATION

If more than one screen, show locations of each on sketch.