

WAYNE

P 35

9-1-71

MISSISSIPPI
 BOARD OF WATER COMMISSIONERS
 416 North State Street
 Jackson, Mississippi 39201

WATER WELL DRILLERS LOG

CODED

Sept 1 1971 Paul Duffek firm name Paul Duffek county well located W

LANDOWNER: Paul Duffek
Box 27 Wagonwheel Miss
 (mailing address)

description of formations encountered	from	to
<u>chert sand</u>	<u>0</u>	<u>35</u>
<u>chert</u>	<u>35</u>	<u>45</u>
<u>red shale</u>	<u>45</u>	<u>63</u>
<u>blue chert</u>	<u>63</u>	<u>117</u>
<u>blue clay rock</u>	<u>117</u>	<u>142</u>

WELL LOCATION:
 sec. 6 T. 80 N. R. 5 E. S. 7 W.
7 miles east of Wagonwheel
 (distance) (direction) (nearest town)

WELL PURPOSE: home
 (home, irrigation, municipal, industrial)

WELL COMPLETION DATA:
 (1) diameter (inches) 2"
 (2) total depth (feet) 142'
 (3) static water level (feet) 92 below top of ground.
 (4) casing steel 118'
 (material) (depth)
2"
 (size) if telescope see back.
 (5) screen iron insert
 (length) (depth to top)
 (size) (material)
 (6) pump 3/4 41
 (HP) (yield gpm)
blue
 (type power)
 (7) electric log no
 (yes or no)
 (organization running log)
 (8) how well bottom plugged no

105' 1 1/2' deep steel

CODED

DRILLERS REMARKS:
no


OCT 6 1971

If well telescopes please sketch and show depths.

0500

GROUND LEVEL

0100

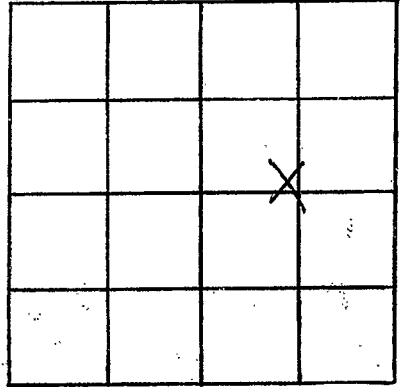

SECTION ~~2~~ 6

Please indicate well location X.

ADDITIONAL INFORMATION

If more than one screen, show locations of each on sketch.