

Wayne
P 36
11-29-71

MISSISSIPPI
BOARD OF WATER COMMISSIONERS
416 North State Street
Jackson, Mississippi 39201
WATER WELL DRILLERS LOG

CODED

11-29-71 19 71 CARRS WATER WELL SERV W WAYNE
date well completed firm name county well located

LANDOWNER: JAMES DEARMAN	description of formations encountered	from	to
RTI BUCATUNNA MISS	Top soil	0	1
	FINE yellow SAND	1	15
	Med To Coarse white SAND	15	26
	BROWN SAND ROCKS		
	yellow CLAY	26	43
	white CLAY	43	53
	Coarse BROWN CRYSTALLINE SAND	53	63
	Coarse white SAND	63	80

(mailing address)

WELL LOCATION:
sec 37 T 8 N R 5 E
S W
4 1/2 miles NINE of BUC
(distance) (direction) (nearest town)

WELL PURPOSE: HOME
(home, irrigation, municipal, industrial)

WELL COMPLETION DATA:


- (1) diameter (inches) 4 1/2"
- (2) total depth (feet) 80
- (3) static water level (feet) 150 ^{below} ~~above~~ top of ground.
- (4) casing PVC, 75' (material) (depth)
(size) if telescope see back.
- (5) screen 5' 75' (length) (depth to top)
2" PVC (size) (material)
- (6) pump 1 (HP) 7 (yield gpm)
Elect (type power)
- (7) electric log NO (yes or no)
(organization running log)
- (8) how well bottom plugged 1" B.W.V.

CODED

DRILLERS REMARKS: ROCK @ 26' 4" THICK & ONE @ 53' 1/4" THICK

If well telescopes please sketch and show depths.

GROUND LEVEL

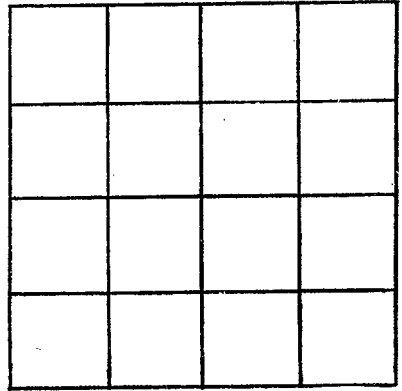

SECTION _____

Please indicate well location X.

ADDITIONAL INFORMATION

If more than one screen,
show locations of each on sketch.