

**WAYNE**  
**P 38**  
**3-29-72**

MISSISSIPPI  
 BOARD OF WATER COMMISSIONERS  
 416 North State Street  
 Jackson, Mississippi 39201

**CODED**


WATER WELL DRILLERS LOG

March 29 1972 Water Drilling Sup Wayne  
 date well completed firm name county well located

LANDOWNER: <u>W. H. Medders</u>	description of formations encountered	from	to
<u>211 Chickatanna Miss</u> (mailing address)	<u>sand &amp; clay</u>	<u>0</u>	<u>13</u>
WELL LOCATION: sec <u>17</u> T <u>8</u> N <u>5</u> R <u>5</u> E <u>W</u>	<u>Chalk</u>	<u>13</u>	<u>21</u>
<u>7</u> miles <u>east</u> of <u>Waynesboro</u> (distance) (direction) (nearest town)	<u>rock</u>	<u>21</u>	<u>24</u>
WELL PURPOSE: <u>none</u> (home, irrigation, municipal, industrial)	<u>blue Chalk</u>	<u>24</u>	<u>79</u>
WELL COMPLETION DATA: (1) diameter (inches) <u>2"</u>	<u>Chickatanna rocks</u>	<u>79</u>	<u>104</u>
(2) total depth (feet) <u>106'</u>	<u>white Chalk</u>	<u>104</u>	<u>106</u>
(3) static water level (feet) <u>6</u> below above top of ground.	<b>CODED</b>	<u>42' 1" log pipe</u>	
(4) casing <u>steel</u> <u>80'</u> (material) (depth)			
<u>2"</u> if telescope see back. (size)			
(5) screen <u>none used</u> (length) (depth to top)			
(size) (material)			
(6) pump <u>3/4</u> <u>12</u> (HP) (yield gpm)			
<u>elec</u> (type power)			
(7) electric log <u>no</u> (yes or no)			
(organization running log)			
(8) how well bottom plugged <u>open</u>			
DRILLERS REMARKS:			

If well telescopes please sketch and show depths.

GROUND LEVEL

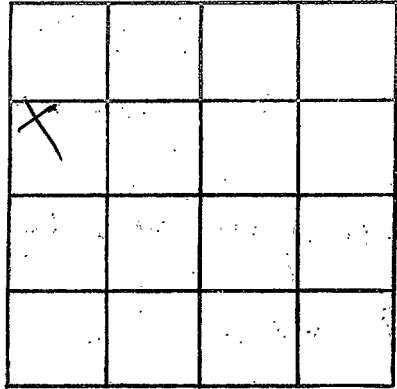

SECTION 17

Please indicate well location X.

ADDITIONAL INFORMATION

If more than one screen,  
show locations of each on sketch.