

**WAYNE**  
**P39**  
**3-30-72**

MISSISSIPPI  
 BOARD OF WATER COMMISSIONERS  
 416 North State Street  
 Jackson, Mississippi 39201

**CODED**

WATER WELL DRILLERS LOG

March 30 1972 Porter Drilling & Log Wayne  
 date well completed firm name county well located

LANDOWNER: Louella  
Worsham  
211 Buckatanna Miss  
 (mailing address)

description of formations encountered	from	to
sand	0	21
chalk	27	40
sand & chalk	40	66
sand	66	69
sand & chalk	69	71
stop on chalk		

WELL LOCATION:  
 sec 21 T 80 N R 5 E  
10 miles east of Waynesboro  
 (distance) (direction) (nearest town)

WELL PURPOSE: none  
 (home, irrigation, municipal, industrial)

WELL COMPLETION DATA:  
 (1) diameter (inches) 2"  
 (2) total depth (feet) 71  
 (3) static water level (feet) 55 (below top of ground) above  
 (4) casing steel 66'  
 (material) (depth)  
2"  
 (size) If telescope see back.  
 (5) screen 5' 66  
 (length) (depth to top)  
1/4" galat S.S.  
 (size) (material)  
 (6) pump 1 10  
 (HP) (yield gpm)  
elec.  
 (type power)  
 (7) electric log no  
 (yes or no)  
 (organization running log)


5' 1 1/4" galat S.S. lined  
in with gracher  
63' 1/4" large pipe

**CODED**

(8) how well bottom plugged  
flush sand  
 DRILLERS REMARKS:

If well telescopes please sketch and show depths.

GROUND LEVEL

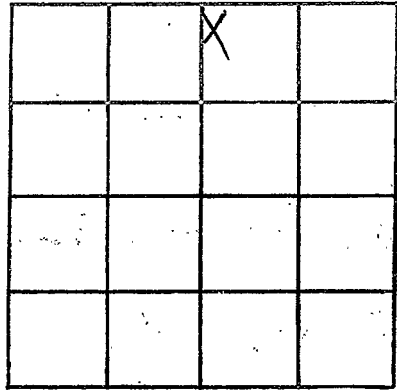

SECTION 21

Please indicate well location X.

ADDITIONAL INFORMATION

If more than one screen, show locations of each on sketch.