

**MISSISSIPPI
BOARD OF WATER COMMISSIONERS**
416 North State Street
Jackson, Mississippi 39201

COVERED
MISS. SD. 12
WATER

WATER WELL DRILLERS LOG

WAYNE
P 43
4-23-73


date well completed 19 April 23 73 Bohr Drilling & Log firm name Wayne county well located

LANDOWNER <u>Earnest Taylor</u>	description of formations encountered	from	to
<u>Box 4, Hainesboro</u> (mailing address)	<u>red clay</u> <u>red sand</u> <u>white sand</u> <u>red sand & chalk</u>	<u>0</u> <u>12</u> <u>29</u> <u>36</u>	<u>12</u> <u>29</u> <u>36</u> <u>39</u>
WELL LOCATION: sec. <u>18</u> T. <u>30</u> N. R. <u>5</u> E. <u>6</u> miles <u>east</u> of <u>Hainesboro</u> (distance) (direction) (nearest town)	<u>26' 1 1/4" drive pipe</u>		
WELL PURPOSE: <u>home</u> (home, irrigation, municipal, industrial)	<u>5' 1 1/4" 6 slot SS</u>		
WELL COMPLETION DATA:	<u>run out on end of cas</u>		
(1) diameter (inches) <u>2"</u>			
(2) total depth (feet) <u>35</u>			
(3) static water level (feet) <u>19</u> <u>below</u> top of ground.			
(4) casing <u>steel</u> , <u>30'</u> (material) (depth)			
<u>2'</u> if telescope see back. (size)			
(5) screen <u>5'</u> , <u>30'</u> (length) (depth to top)			
<u>1 1/4"</u> <u>6 slot SS.</u> (size) (material)			
(6) pump <u>1/3</u> , <u>6</u> (HP) (yield gpm)			
<u>elec.</u> (type power)			
(7) electric log <u>no</u> (yes or no)			
(organization running log)			
(8) how well bottom plugged <u>plug point</u>			
DRILLERS REMARKS:			

COVERED

If well telescopes please sketch and show depths.

GROUND LEVEL

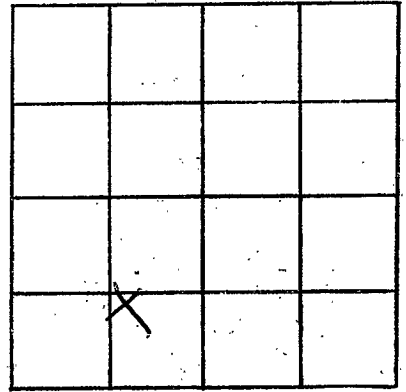

SECTION 18

Please indicate well location X.

ADDITIONAL INFORMATION

If more than one screen,
show locations of each on sketch.