

WAYNE
P 44
5-17-73

MISSISSIPPI
BOARD OF WATER COMMISSIONERS
416 North State Street
Jackson, Mississippi 39201

CODED

WATER WELL DRILLERS LOG

5/17 1973 Caris well serv Wayne
date well completed firm name county well located

LANDOWNER: Mary Worsham
Rt. B. Buckner, Miss
(mailing address)

description of formations encountered	from	to
top soil	0	1
Red SAND w/ CLAY	1	15
Yellow med SAND	15	27
Med white SAND	27	53
white CLAY	53	54
Coarse white SAND	54	65

WELL LOCATION:
sec 21 T 3 N R 5 E
S W
6 miles NNE of BUC
(distance) (direction) (nearest town)

WELL PURPOSE: Home
(home, irrigation, municipal, industrial)

WELL COMPLETION DATA:

(1) diameter (inches) 4 3/8 x 2

(2) total depth (feet) 65

(3) static water level (feet) 54 ^{below} top of ground.

(4) casing Galv. 61
(material) (depth)
(size) If telescope see back.

(5) screen 4" 61'
(length) (depth to top)
2" PVC (856)
(size) (material)

(6) pump 1/2 4 1/2
(HP) (yield gpm)
Elec f
(type power)

(7) electric log no
(yes or no)
(organization running log)

(8) how well bottom plugged 2" B.W.V.


DRILLERS REMARKS: Have 3'
1 1/4" tail pipe on
cylinder

CODED

MAY 17 1973

If well telescopes please sketch and show depths.

GROUND LEVEL

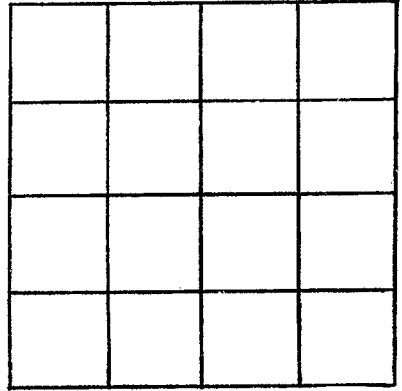

SECTION _____

Please indicate well location X.

ADDITIONAL INFORMATION

A series of horizontal lines for entering additional information.

one screen,
as of each on sketch.