

WAYNE
P 45
7-23-73

MISSISSIPPI
BOARD OF WATER COMMISSIONERS
416 North State Street
Jackson, Mississippi 39201

CODED

WATER WELL DRILLERS LOG

July 10, 1973 date well completed
M&L SWAIN Well SER firm name
Wayne county well located


LANDOWNER:	description of fomations encountered	from	to
SLATER WEST	Red Clay	0	12
Rt 1 BUCKATONNA, Miss. (mailing address)	Red Sand	12	28
WELL LOCATION:	White Sand	28	35
sec. 4 T 8 N R 5 W	White Chalk	35	38
9 miles E of W' BORO (distance) (direction) (nearest town)	Sand	38	85
WELL PURPOSE: (home, irrigation, municipal, industrial)	Clay + sand	85	105
WELL COMPLETION DATA:	Coarse Sand + gravel	105	113
(1) diameter (inches) 2"			
(2) total depth (feet) 113'			
(3) static water level (feet) 76' below above top of ground.			
(4) casing PVC 107' (material) (depth)			
2" if telescope see back. (size)			
(5) screen 5' 107' (length) (depth to top)			
2" PVC .008 (size) (material)			
(6) pump 1 7 (HP) (yield gpm)			
220 AC (type power)			
(7) electric log yes (yes or no)			
(organization running log)			
(8) how well bottom plugged			

JUL 18 1973

DRILLERS REMARKS:

If well telescopes please sketch and show depths.

GROUND LEVEL

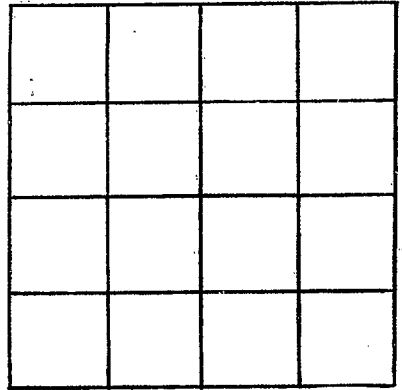

SECTION _____

Please indicate well location X.

ADDITIONAL INFORMATION

If more than one screen, show locations of each on sketch.