

WAYNE

~~22~~ P46

6-13-73

MISSISSIPPI  
BOARD OF WATER COMMISSIONERS  
416 North State Street  
Jackson, Mississippi 39201

CODED

WATER WELL DRILLERS LOG

June 13 1973 Porter Drilling & Log Wayne  
date well completed firm name county well located

LANDOWNER: Leroy Singley

description of formations encountered

211 Buckatunna Miss  
(mailing address)

red clay  
sand  
chall

WELL LOCATION:  
sec 32 T. 8 N. R. 5 E. S. 1 W.  
6 miles N of Buckatunna  
(distance) (direction) (nearest town)

fine sand  
thin rock  
stayed on chalth

from	to
0	12
12	29
29	73
73	91
91	92

WELL PURPOSE: home  
(home, irrigation, municipal, industrial)

6' 1 1/4" 80 gpm S.S. screen

WELL COMPLETION DATA:

with 6' 1 1/4" log pipe  
test in with cylinder

- (1) diameter (inches) 2"
- (2) total depth (feet) 91'
- (3) static water level (feet) 70 (below above top of ground)
- (4) casing steel 82'  
(material) (depth)  
2" if telescope see back.  
(size)
- (5) screen 6' 85'  
(length) (depth to top)  
1/4" 80 gpm S.S.  
(size) (material)
- (6) pump 3000 3 1/2  
(HP) (yield gpm)  
elec  
(type power)
- (7) electric log no  
(yes or no)
- (organization running log)
- (8) how well bottom plugged  
flush ground

CODED


DRILLERS REMARKS:

JUN 31 1973

MISSISSIPPI BOARD OF WATER COMMISSIONERS

If well telescopes please sketch and show depths.

GROUND LEVEL

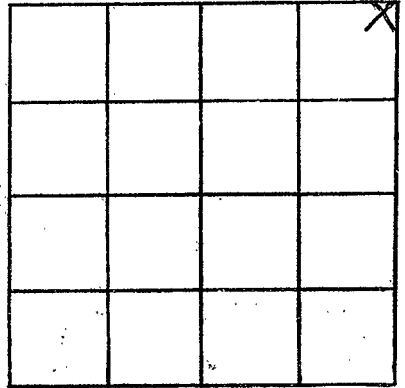

SECTION 32

Please indicate well location X.

ADDITIONAL INFORMATION

If more than one screen,  
show locations of each on sketch.