

WAYNE  
P47  
9-5-73

MISSISSIPPI  
BOARD OF WATER COMMISSIONERS  
416 North State Street  
Jackson, Mississippi 39201

WATER WELL DRILLERS LOG

**CODED**

SEPT 5, 1973  
date well completed

McILWAIN WATER WELL SERVICE

WAYNE

RT. 2 BOX 37

county well located

WAYNESBORO, MISS. 39367


LANDOWNER:	description of formations encountered	from	to
Houston BEASLEY			
RT 1 BUCATUNNA, MISS. (mailing address)	SAND	5	23
WELL LOCATION: sec. 11 T-80N R-5W 10 miles E of W'BORO (distance) (direction) (nearest town)	CLAY	23	25
	SAND	25	46
WELL PURPOSE: HOME (home, irrigation, municipal, industrial)	CLAY	46	62
WELL COMPLETION DATA:	SAND	62	73
(1) diameter (inches) 2"	CLAY	73	75
(2) total depth (feet) 85'	SAND	75	85
(3) static water level (feet) 38' below top of ground.			
(4) casing PVC 75' (material) (depth)			
2" (size) if telescope see back.			
(5) screen 10' 75' (length) (depth to top)			
2" PVC .008 (size) (material)			
(6) pump 1/2 9 (HP) (yield gpm)			
110 AC (type power)			
(7) electric log NO (yes or no)			
(organization running log)			
(8) how well bottom plugged			
DRILLERS REMARKS:			

**CODED**

SEP 19 1973

If well telescopes please sketch and show depths.

GROUND LEVEL

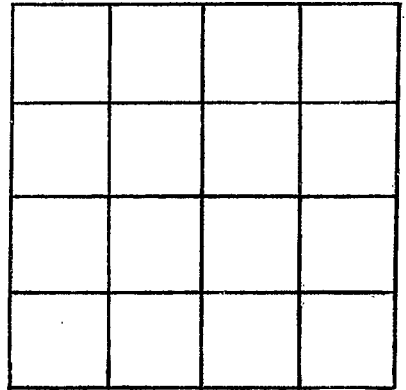

SECTION \_\_\_\_\_

Please indicate well location X.

ADDITIONAL INFORMATION

If more than one screen,  
show locations of each on sketch.