

MISSISSIPPI
BOARD OF WATER COMMISSIONERS
416 North State Street
Jackson, Mississippi 39201

CODED SEP 12 1973

WATER WELL DRILLERS LOG

MISS. BD. OF
WATER COMMISSIONERS


WAYNE
P 48
7-16-73

July 16 1973 date well completed
Port. Drilling & Dig firm name
Miss. county well located

LANDOWNER: <u>A. J. Singler</u>	description of formations encountered	from	to
<u>R11 Buckatunna, Miss</u> (mailing address)	<u>red clay</u>	<u>0</u>	<u>15</u>
	<u>fine sand</u>	<u>15</u>	<u>18</u>
	<u>chert</u>	<u>18</u>	<u>30</u>
	<u>fine sand</u>	<u>30</u>	<u>45</u>
	<u>hard coarse white sand</u>	<u>45</u>	<u>52</u>
	<u>medium coarse red sand</u>	<u>52</u>	<u>56</u>
	<u>rock</u>		<u>56</u>
WELL LOCATION: sec. <u>33</u> T. <u>8</u> N. R. <u>5</u> E. <u>5</u> miles N of <u>Buckatunna</u> (distance) (direction) (nearest town)			
WELL PURPOSE: <u>Domestic</u> (home, irrigation, municipal, industrial)			
WELL COMPLETION DATA:			
(1) diameter (inches) <u>2"</u>			
(2) total depth (feet) <u>52</u>			
(3) static water level (feet) <u>30</u> below above top of ground.			
(4) casing <u>plastic</u> , <u>47'</u> (material), (depth)			
<u>2"</u> if telescope see back. (size)			
(5) screen <u>5'</u> , <u>47'</u> (length), (depth to top)			
(6) pump <u>1</u> , <u>10</u> (HP), (yield gpm)			
(7) electric log <u>no</u> (yes or/no)			
(organization running log)			
(8) how well bottom plugged <u>not plugged</u>			
DRILLERS REMARKS:	<u>45' 1" galv. pipe</u> <u>GODLL</u>		

If well telescopes please sketch and show depths.

GROUND LEVEL

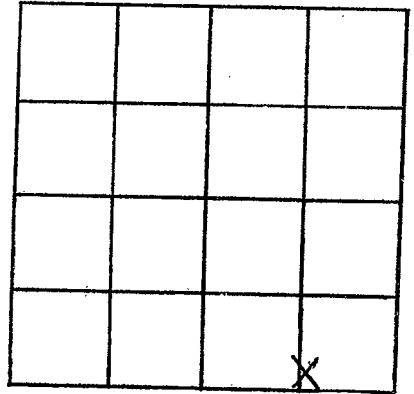

SECTION 33

Please indicate well location X.

ADDITIONAL INFORMATION

If more than one screen,
show locations of each on sketch.