

WAYNE
P 49
11-14-73

MISSISSIPPI
BOARD OF WATER COMMISSIONERS
416 North State Street
Jackson, Mississippi 39201

CODER

WATER WELL DRILLERS LOG

McILWAIN WATER WELL SERVICE WAYNE

Nov. 14, 1973
date well completed


RT-2 BOX 37
WAYNESBORO, MISS. 39367

county well located

LANDOWNER:	description of formations encountered	from	to
WOODROW HUFFMAN	RED CLAY	0	8
RT 2 W'BORO (mailing address)	RED SAND + GRAVEL	8	20
WELL LOCATION: sec. 7 T. 8 N R. 5 E 8 miles E of W'BORO (distance) (direction) (nearest town)	WHITE SAND + PEA GRAVEL	20	41
WELL PURPOSE: HOME (home, irrigation, municipal, industrial)	CODER		
WELL COMPLETION DATA:			
(1) diameter (inches) 2"			
(2) total depth (feet) 41'			
(3) static water level (feet) 21' below top of ground.			
(4) casing PVC 31' (material) (depth) 2" (size) if telescope see back.			
(5) screen 10' 31' (length) (depth to top) 2" PVC .008 (size) (material)			
(6) pump 1 (HP) 11 (yield gpm) 110 AC (type power)			
(7) electric log No (yes or no)			
(organization running log)			
(8) how well bottom plugged			
DRILLERS REMARKS:			

If well telescopes please sketch and show depths.

GROUND LEVEL

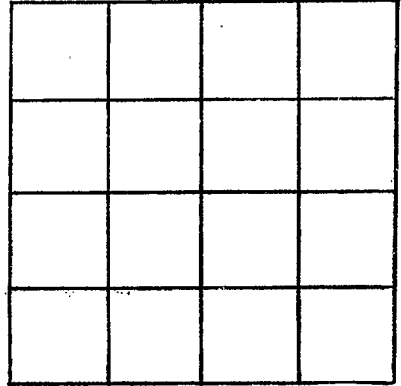

SECTION _____

Please indicate well location X.

ADDITIONAL INFORMATION

If more than one screen, show locations of each on sketch.