

MISSISSIPPI
 BOARD OF WATER COMMISSIONERS
 416 North State Street
 Jackson, Mississippi 39201

CODED

JDED

WATER WELL DRILLERS LOG

WAYNE
P50
12-12-73

DEC 12, 1973 19 **McILWAIN WATER WELL SERVICE** **WAYNE**
 date well completed RT. 2, **BOX 37** county well located
WAYNESBORO, MISS. 39367

LANDOWNER:
LAMAR RAMEY
RT 2 WAYNESBORO, MISS.
 (mailing address)

WELL LOCATION:
 sec. 3 T 8 N R. 5 E
10 miles E of W BORO
 (distance) (direction) of (nearest town)

WELL PURPOSE: HOME
 (home, irrigation, municipal, industrial)

WELL COMPLETION DATA:

(1) diameter (inches) 2"

(2) total depth (feet) 116

(3) static water level (feet) 70' below top of ground. ~~above~~

(4) casing PVC, 106' (material) (depth)
2" if telescope see back. (size)

(5) screen 10', 106' (length) (depth to top)
2", PVC .008 (size) (material)

(6) pump 1, 8 (HP) (yield gpm)
220 AC (type power)

(7) electric log NO (yes or no)

(organization running log)

(8) how well bottom plugged

description of formations encountered	from	to
Red Clay	0	06
Red sand	06	10
Pink + White clay	10	55
Med sand and clay streaks	55	80
Coarse sand	80	95
Clay	95	100
Med sand	100	116


CODED

RECEIVED
 JAN 1 1974
 MISS. DD. OF WATER COM.

DRILLERS REMARKS:

If well telescopes please sketch and show depths.

GROUND LEVEL

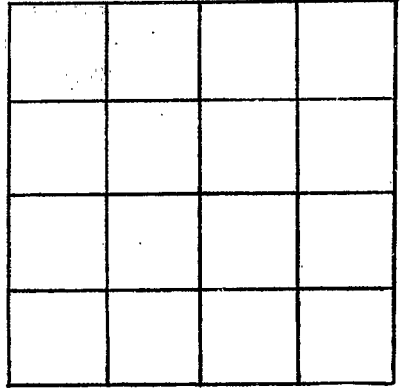

SECTION _____

Please indicate well location X.

ADDITIONAL INFORMATION

If more than one screen,
show locations of each on sketch.