

WAYNE
P 51
2-20-74

MISSISSIPPI
 BOARD OF WATER COMMISSIONERS
 416 North State Street
 Jackson, Mississippi 39201
WATER WELL DRILLERS LOG

2 20 19 74 CARRS well SERVICE WAYNE
 date well completed firm name county well located


LANDOWNER: <u>OSCAR KIRKLAND</u>	description of formations encountered	from	to
<u>Rt 1 Bucaturunna Miss</u>	<u>Top Soil</u>	<u>0</u>	<u>1</u>
	<u>Red SAND</u>	<u>1</u>	<u>15</u>
	<u>Med white SAND</u>	<u>15</u>	<u>22</u>
(mailing address)	<u>Coarse white SAND</u>	<u>22</u>	<u>29</u>
WELL LOCATION:	<u>Pen Gravel</u>	<u>29</u>	<u>31</u>
sec. <u>35</u> T. <u>8</u> N. R. <u>5</u> E	<u>white CLAY</u>	<u>31</u>	<u>33</u>
<u>1 3/4</u> miles <u>ENE</u> of <u>PROGRESS</u>	<u>pink+white CLAY</u>	<u>33</u>	<u>48</u>
(distance) (direction) of (nearest town)	<u>Bluish CLAY</u>	<u>48</u>	<u>54</u>
WELL PURPOSE: <u>Home</u>	<u>pink CLAY</u>	<u>54</u>	<u>65</u>
(home, irrigation, municipal, industrial)	<u>white CLAY</u>	<u>65</u>	<u>70</u>
WELL COMPLETION DATA:	<u>Med white SAND</u>	<u>70</u>	<u>73</u>
(1) diameter (inches) <u>4" x 2"</u>	<u>BROWN Rock</u>	<u>73</u>	<u>74</u>
(2) total depth (feet) <u>90</u>	<u>Broken white clay + S.D.</u>	<u>74</u>	<u>77</u>
(3) static water level (feet) <u>54</u> ^{below} _{above} top of ground.	<u>Coarse white SAND</u>	<u>77</u>	<u>90</u>
(4) casing <u>PVC 86</u> (material) (depth)			
(size) If telescope see back.			
(5) screen <u>4'</u> <u>86</u> (length) (depth to top)			
<u>2"</u> <u>PVC 86</u> (size) (material)			
(6) pump <u>7</u> (HP) (yield gpm)			
<u>Elect</u> (type power)			
(7) electric log <u>No</u> (yes or no)			
(organization running log)			
(8) how well bottom plugged <u>B.W.V.</u>			
DRILLERS REMARKS: <u>Still in same when 94 ft</u>			

CODED

APR 22 1974

If well telescopes please sketch and show depths.

GROUND LEVEL

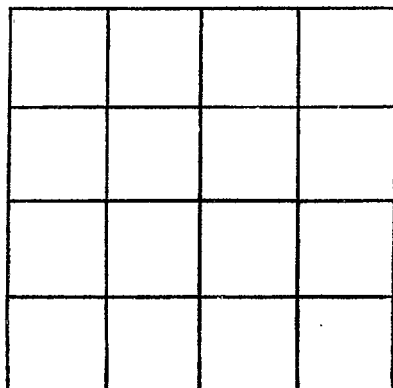

SECTION _____

Please indicate well location X.

ADDITIONAL INFORMATION

If more than one screen,
show locations of each on sketch.