

WAYNE  
PS2  
5-24-74

MISSISSIPPI  
BOARD OF WATER COMMISSIONERS  
416 North State Street  
Jackson, Mississippi 39201

WATER WELL DRILLERS LOG

CODED

MAY 24, 1974 19 McILWAIN WATER WELL SERVICE WAYNE  
date well completed RT. 4, Box 37 county well located

WAYNESBORO, MISS. 39367


LANDOWNER:	description of formations encountered	from	to
FRED ANDREWS	Red Clay	0	12
Rt 1, BUCATUNNA (mailing address)	Red Sand	12	20
WELL LOCATION:	White Sand	20	30
sec. 29 T 8 N R. 5 E	Red Sand + Dome		
11 miles SE of W. BOARD	Clay	30	55
(distance) (direction) (nearest town)	Clay	55	58
WELL PURPOSE: HOME	Sand	58	65
(home, irrigation, municipal, industrial)	Clay	65	70
WELL COMPLETION DATA:	Sand	70	117
(1) diameter (inches) 2"			
(2) total depth (feet) 117'			
(3) static water level (feet) 95' below top of ground.			
(4) casing PVC 107' (material), 2" (size) If telescope see back.			
(5) screen 10' 107' (length), 2" PVC .008 (size), (material)			
(6) pump 2 (HP), 8 (yield gpm)			
(7) electric log 220 AC (type power), 470 (yes or no)			
(organization running log)			
(8) how well bottom plugged			
DRILLERS REMARKS:			

RECEIVED  
MAY 10 1974

MISS. BD. OF WATER COMMISSIONERS

If well telescopes please sketch and show depths.

GROUND LEVEL

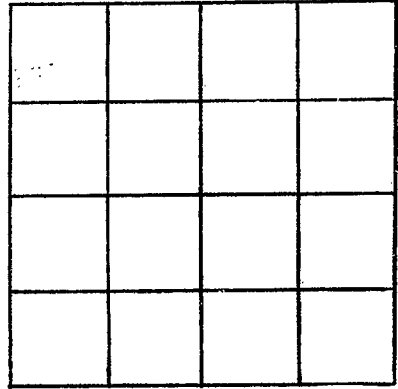

SECTION \_\_\_\_\_

Please indicate well location X.

ADDITIONAL INFORMATION

If more than one screen,  
show locations of each on sketch.