

WAYNE
P 54
6-25-74

MISSISSIPPI
 BOARD OF WATER COMMISSIONERS
 416 North State Street
 Jackson, Mississippi 39201 **CODED**

WATER WELL DRILLERS LOG

JUNE 25, 74 19 **McILWAIN WATER WELL SERVICE WAYNE**
 date well completed RT. **Box 37** county well located

WAYNESBORO, MISS. 39367

LANDOWNER:

Tommy Palmer
Rt 4 WAYNESBORO, Miss
 (mailing address)

description of formations encountered

from to

WELL LOCATION:

sec. **17** T. **8** N R. **5** E
8 miles (distance) **E** (direction) of **Waynesboro** (nearest town)

WELL PURPOSE: **HOME**
 (home, irrigation, municipal, industrial)

WELL COMPLETION DATA:

- (1) diameter (inches) **2"**
- (2) total depth (feet) **85'**
- (3) static water level (feet) **39'** below top of ground.
- (4) casing **PVC 80'** (material) (depth)
2" (size) if telescope see back.
- (5) screen **5' 80'** (length) (depth to top)
2" (size) **PVC .008** (material)
- (6) pump **1 12** (HP) (yield gpm)
220 Ac (type power)
- (7) electric log **NO** (yes or no)

Red Clay	0	10
Sand	10	12
Clay	12	16
Coarse Red Sand	16	22
Med. Sand	22	30
Sand and Clay	30	40
Clay	40	45
Sand	45	55
Sand + Clay Strata	55	65
Clay	65	72
Clay	72	74
Sand	74	85

(organization running log)

(8) how well bottom plugged

DRILLERS REMARKS:


RECEIVED

JUL 15 1974

MISS. BD. OF WATER COMMISSIONERS

If well telescopes please sketch and show depths.

GROUND LEVEL

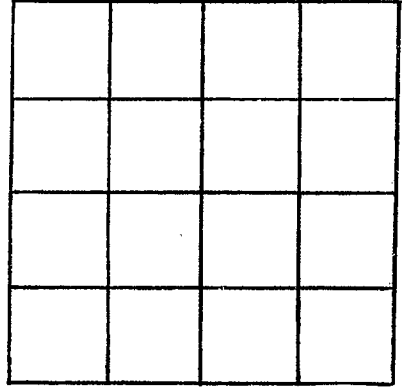

SECTION _____

Please indicate well location X.

ADDITIONAL INFORMATION

If more than one screen, show locations of each on sketch.