

WAYNE

P56

7-25-74

MISSISSIPPI
 BOARD OF WATER COMMISSIONERS
 416 North State Street
 Jackson, Mississippi 39201

CODE

WATER WELL DRILLERS LOG

July 25, 1974
date well completed

McILWAIN WATER WELL SERVICE WAYNE
RT. 2, BOX 37 county well located

LANDOWNER:

LAWRENCE TAYLOR
RT 4 WAYNESBORO, MISS.
(mailing address)

description of formations encountered

	from	to
RED CLAY	0	4
MIXED CLAY	4	12
WHITE CHALK	12	30
MIXED CLAY, SOME SAND ROCK	30	55
CLAY (GUMBO AND HEAVING SHALE)	55	113
Rock	113	113 1/2
SAND & pea gravel	113 1/2	120

WELL LOCATION:

sec 32 T 8 N R 5 E
6 miles N of BURATUMMA
(distance) (direction) (nearest town)

WELL PURPOSE: HOME
(home, irrigation, municipal, industrial)

WELL COMPLETION DATA:

- (1) diameter (inches) 2"
- (2) total depth (feet) 120'
- (3) static water level (feet) 80' below top of ground
- (4) casing PVC 114' (material) (depth)
2" (size) if telescope see back.
- (5) screen 6' 114' (length) (depth to top)
1/4" PVC .008 (size) (material)
- (6) pump 1 (HP) 7 1/2 (yield gpm)
220 AC (type power)
- (7) electric log NO (yes or no)

(organization running log)


(8) how well bottom plugged

DRILLERS REMARKS:

DRILLER'S SIGNATURE
 AUG 15 1974
 MISS. Bd. OF WAI

If well telescopes please sketch and show depths.

GROUND LEVEL

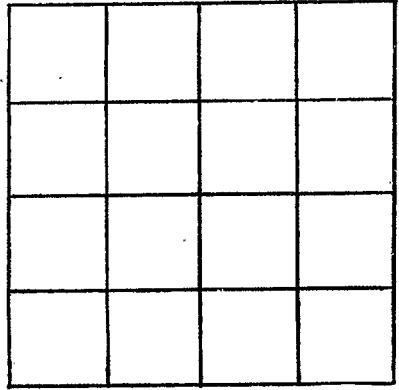

SECTION _____

Please indicate well location X.

ADDITIONAL INFORMATION

If more than one screen,
show locations of each on sketch.