

WAYNE  
P 57  
7-6-74

MISSISSIPPI  
BOARD OF WATER COMMISSIONERS  
416 North State Street  
Jackson, Mississippi 39201

CODED

WATER WELL DRILLERS LOG  
McILWAIN WATER WELL SERVICE

July 6, 1974  
date well completed

RT. 2 BOX 37

WAYNE

WAYNESBORO, MISS. 39367

county well located

LANDOWNER:	description of formations encountered	from	to
BEATRICE EVERITT	Clay	0	11
WAYNESBORO, Miss. (mailing address)	Red Sand	11	13
WELL LOCATION:	White Sand	13	16
sec. 15 T. 8 N R. 5 W	Coarse Sand + pea gravel	16	21
10 miles E of W'BORO (distance) (direction) (nearest town)	Clay	21	22
WELL PURPOSE: HOME (home, irrigation, municipal, industrial)	Fine White Sand	22	25
WELL COMPLETION DATA:	med Sand	25	29
(1) diameter (inches) 2"	Clay	29	30
(2) total depth (feet) 45'	Coarse Sand	30	45
(3) static water level (feet) 23' below top of ground.			
(4) casing PVC 40' (material) (depth)			
2" If telescope see back. (size)			
(5) screen 5' 40' (length) (depth to top)			
2" PVC .008 (size) (material)			
(6) pump 1 12 (HP) (yield gpm)			
220 AC (type power)			
(7) electric log NO (yes or no)			
(organization running log)			
(8) how well bottom plugged			
DRILLERS REMARKS:			


CODED

DECEMBER 13 1974

MISS. BD. OF WATER COMMISSIONERS

If well telescopes please sketch and show depths.

GROUND LEVEL

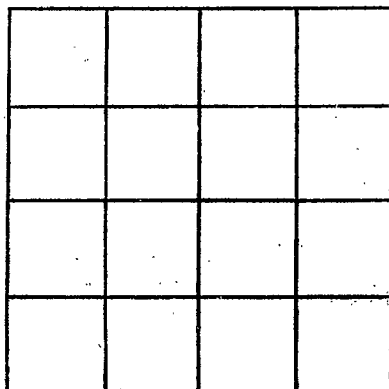

SECTION \_\_\_\_\_

Please indicate well location X.

ADDITIONAL INFORMATION

If more than one screen, show locations of each on sketch.