

**MISSISSIPPI
BOARD OF WATER COMMISSIONERS**
416 North State Street
Jackson, Mississippi 39201

CODED

WAYNE

P 59

7-25-74

WATER WELL DRILLERS LOG

July 25 1974 Porter Drilling Wayne
date well completed firm name county well located

LANDOWNER: Samuel L. Raptist Church
211 Buckatanna
(mailing address)

description of formations encountered	from	to
clay & sand	0	22
shale	22	23
chalk	23	70
sand & chalk	70	80
med. coarse sand	80	95
soft chalk & sand	95	100
low med. coarse sand	100	111
sand & chalk	111	115
shale on chalk		

WELL LOCATION:
sec. 3 T. 20 N. R. 5 E. S. 10
10 miles E of Wayne
(distance) (direction) (nearest town)

WELL PURPOSE: Church
(home, irrigation, municipal, industrial)

- WELL COMPLETION DATA:**
- (1) diameter (inches) 2"
 - (2) total depth (feet) 111'
 - (3) static water level (feet) 70 below above top of ground.
 - (4) casing PVC 105'
(material) (depth)
2" if telescope see back.
(size)
 - (5) screen 5' 105'
(length) (depth to top)
2" 10 slot P.V.C
(size) (material)
 - (6) pump 1 8
(HP) (yield gpm)
dec.
(type power)
 - (7) electric log no
(yes or no)

(organization running log)

(8) how well bottom plugged backwash valve


DRILLERS REMARKS:

RECEIVED

SEP 11 1974

If well telescopes please sketch and show depths.

GROUND LEVEL

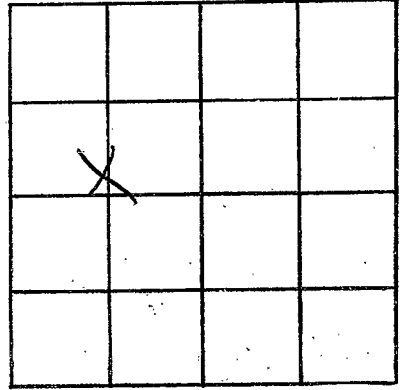

SECTION 3

Please indicate well location X.

ADDITIONAL INFORMATION

If more than one screen,
show locations of each on sketch.