

WAYNE
P60
9-10-74

MISSISSIPPI
BOARD OF WATER COMMISSIONERS
416 North State Street
Jackson, Mississippi 39201
WATER WELL DRILLERS LOG

CODED

9-10 1974 CAPPS well service WAYNE
date well completed firm name county well located

LANDOWNER: <u>JAMES EVRETT</u>	description of formations encountered	from	to
<u>Rt1 BECATUNNA MISS</u>	<u>TOP SOIL</u>	<u>0</u>	<u>1</u>
(mailing address)	<u>Red sandy CLAY</u>	<u>1</u>	<u>15</u>
WELL LOCATION:	<u>COARSE yellowish SD</u>	<u>20</u>	<u>35</u>
sec. <u>9 T-80N S</u> R. <u>5 E</u>	<u>COARSE white SD</u>	<u>35</u>	<u>45</u>
<u>9</u> miles <u>EAST</u> of <u>WABO</u>	<u>FIN GRAVEL w/ white CLAY</u>	<u>45</u>	<u>55</u>
(distance) (direction) (nearest town)	<u>yellow white CLAY</u>	<u>55</u>	<u>60</u>
WELL PURPOSE: <u>HOME</u>	<u>White CLAY</u>	<u>60</u>	<u>70</u>
(home, irrigation, municipal, industrial)	<u>Med White SAND</u>	<u>70</u>	<u>88</u>
WELL COMPLETION DATA:	<u>COARSE white SAND</u>	<u>88</u>	<u>100</u>
(1) diameter (inches) <u>2"</u>	<u>still in SD when</u>		
(2) total depth (feet) <u>100</u>	<u>FEET CODED</u>		
(3) static water level (feet) <u>63</u> <input checked="" type="checkbox"/> below <input type="checkbox"/> above top of ground.			
(4) casing <u>PVC</u> , <u>95</u> (material) (depth)			
(size) If telescope see back.			
(5) screen <u>5'</u> , <u>95</u> (length) (depth to top)			
<u>2"</u> , <u>PVC (8 slot)</u> (size) (material)			
(6) pump <u>1</u> , <u>6</u> (HP) (yield gpm)			
<u>Elect</u> (type power)			
(7) electric log <u>No</u> (yes or no)			
(organization running log)			
(8) how well bottom plugged <u>2" B.W.K.</u>			
DRILLERS REMARKS:			


MISSISSIPPI
BOARD OF WATER COMMISSIONERS
OCT 10 1974

MISS. BD. OF WATER COMMISSIONERS

If well telescopes please sketch and show depths.

GROUND LEVEL

DATE 11/11/00

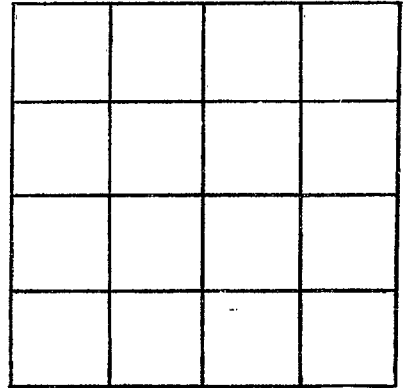

SECTION _____

Please indicate well location X.

ADDITIONAL INFORMATION

If more than one screen, show locations of each on sketch.