

WAYNE  
 P61  
 10/23/74

MISSISSIPPI  
 BOARD OF WATER COMMISSIONERS  
 416 North State Street  
 Jackson, Mississippi 39201

CODED

WATER WELL DRILLERS LOG

Oct 23, 1974<sup>19</sup> McILWAIN WATER WELL SERVICE Wayne  
 date well completed RT. firm name BOX 37 county well located

WAYNESBORO, MISS. 39367

LANDOWNER:  
 Gene Rean  
 Rt 4 Waynesboro, Miss  
 (mailing address)

description of formations encountered	from	to
Red Clay	0	5
Clay	5	15
Hard grey clay	15	73
Rock	73	74
Clay	74	76
Sand	76	85

WELL LOCATION:  
 sec. 27 T 8 N R. 5 W  
 5 miles SE of DENHAM  
 (distance) (direction) (nearest town)


WELL PURPOSE: HOME  
 (home, irrigation, municipal, industrial)

- WELL COMPLETION DATA:
- (1) diameter (inches) 2"
  - (2) total depth (feet) 85'
  - (3) static water level (feet) 47' below top of ground
  - (4) casing PVC 80' (material) (depth)  
 2" (size) If telescope see back.
  - (5) screen 5' 80' (length) (depth to top)  
 2" PVC .008 (size) (material)
  - (6) pump 1 7 (HP) (yield gpm)  
 110 AC (type power)
  - (7) electric log NO (yes or no)

(organization running log)


(8) how well bottom plugged

DRILLERS REMARKS:

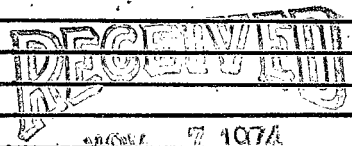

If well telescopes please sketch and show depths.

GROUND LEVEL

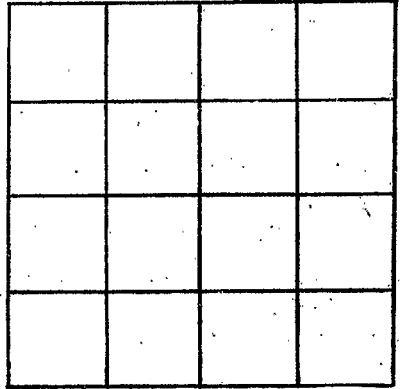

SECTION \_\_\_\_\_

Please indicate well location X.

ADDITIONAL INFORMATION

If more than one screen, show locations of each on sketch.