

WAYNE
P62
5-1-75

MISSISSIPPI
 BOARD OF WATER COMMISSIONERS
 416 North State Street
 Jackson, Mississippi 39201

CODED

WATER WELL DRILLERS LOG

312
 Wayne

MAY 1, 1975
 date well completed

McILWAIN WATER WELL SERVICE

BOX 37
 Rt. firm name
 WAYNESBORO, MISS. 39367

county well located


LANDOWNER:	description of formations encountered	from	to
A. C. EVERETT	Red Clay	0	12
RT 2 WAYNESBORO, MISS (mailing address)	Red Sand and clay	12	28
WELL LOCATION:	Clay	28	36
sec. 3 T. 8 N R. 5 E 10 miles E of W'BORO (distance) (direction) (nearest town)	Sand	36	48
WELL PURPOSE: HOME (home, irrigation, municipal, industrial)	Clay + Sand rock	48	55
WELL COMPLETION DATA:	Sand	55	78
(1) diameter (inches) 2"	Sand Rock	78	78 1/2
(2) total depth (feet) 94'	Sand	78 1/2	94
(3) static water level (feet) 62' below top of ground.			
(4) casing PVC 89' (material) (depth) 2" If telescope see back. (size)			
(5) screen 5' 89' (length) (depth to top) 2" PVC 008 (size) (material)			
(6) pump 1 9 (HP) (yield gpm) 110 AC (type power)			
(7) electric log NO (yes or no)			
(organization running log)			
(8) how well bottom plugged			
DRILLERS REMARKS:			

RECEIVED
 MAY 14 1975

MISS. BD. OF WATER COMMISSIONERS

If well telescopes please
sketch and show depths.

GROUND LEVEL

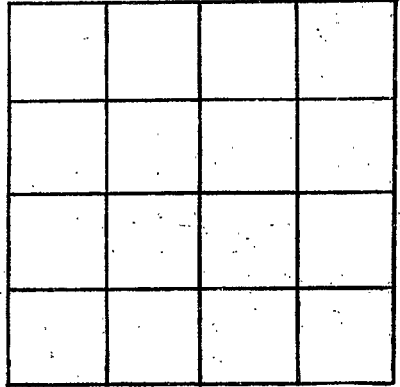

SECTION _____

Please indicate well location X.

ADDITIONAL INFORMATION

If more than one screen,
show locations of each on sketch.