

CODED

Wayne
P 630
6-23-75

MISSISSIPPI
BOARD OF WATER COMMISSIONERS
416 North State Street
Jackson, Mississippi 39201

WATER WELL DRILLERS LOG

JUNE 23, 1975 19 McILWAIN WATER WELL SERVICE Wayne
date well completed Rt. # Box 31 county well located
WAYNESBORO MISS 39267


LANDOWNER:	description of formations encountered	from	to
MR Houston BEASLEY Rt 4 WAYNESBORO, MISS. (mailing address)			
	Red sand	8	18
	Sand & Dome Clay	18	20
	Clay	20	26
	Sand, Dome Clay	26	70
	Coarse Sand	70	85
WELL LOCATION:			
sec. 11 T. 8 N R. 5 E 13 P 10 miles E of W'BORO (distance) (direction) (nearest town)			
WELL PURPOSE: FARM (home, irrigation, municipal, industrial)			
WELL COMPLETION DATA:			
(1) diameter (inches) 2"			
(2) total depth (feet) 85'			
(3) static water level (feet) 31' below top of ground			
(4) casing PVC 80' (material) (depth) 2" if telescope see back. (size)			
(5) screen 5' 80' (length) (depth to top) 2" PVC, 008 Slot (size) (material)			
(6) pump 1 8 (HP) (yield gpm) 220 AC (type power)			
(7) electric log NO (yes or no) (organization running log)			
(8) how well bottom plugged			
DRILLERS REMARKS:			

RECEIVED
JUL 24 1975

MISS. Bd. OF WATER COMMISSIONERS

If well telescopes please sketch and show depths.

GROUND LEVEL

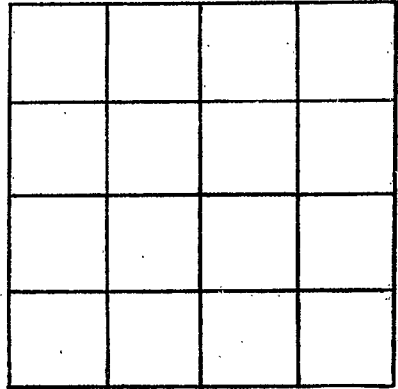

SECTION _____

Please indicate well location X.

ADDITIONAL INFORMATION

If more than one screen, show locations of each on sketch.