

CODED

WAYNE  
 P 64  
 7-30-75

MISSISSIPPI  
 BOARD OF WATER COMMISSIONERS  
 416 North State Street  
 138 Jackson, Mississippi 39201  
 WATER WELL DRILLERS LOG

July 30, 1975 date well completed  
 McILWAIN WATER WELL SERVICE RT. 4, BOX 37  
 WAYNE county well located

LANDOWNER:	description of formations encountered	from	to
WALTER GILES	RED CLAY	0	12
RT. 4 WAYNESBORO, MISS. (mailing address)	MIXED CLAY	12	16
WELL LOCATION: sec. 7 T. 8 N R. 5 E 8 miles E of W. BORO (distance) (direction) (nearest town)	SAND & CLAY	16	35
WELL PURPOSE: HOME (home, irrigation, municipal, industrial)	SAND	35	54
WELL COMPLETION DATA:			
(1) diameter (inches) 2"			
(2) total depth (feet) 54'			
(3) static water level (feet) 35' below top of ground.			
(4) casing PVC 49' (material) (depth) 2" if telescope see back. (size)			
(5) screen 5' 49' (length) (depth to top) 2" PVC .008 Slot (size) (material)			
(6) pump 1/2 7 (HP) (yield gpm) 110 AC (type power)			
(7) electric log NO (yes or no)  (organization running log)			
(8) how well bottom plugged			
DRILLERS REMARKS:			


RECORDED  
 INDEXED

AUG 19 1975

MISS. BD. OF WATER COMMISSIONERS

If well telescopes please sketch and show depths.

GROUND LEVEL

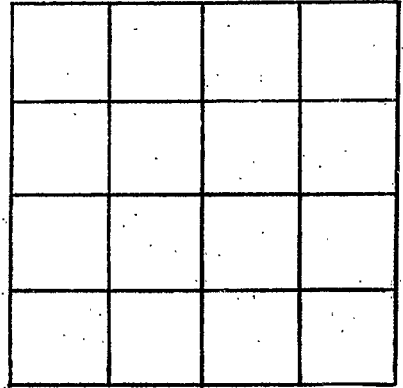

SECTION \_\_\_\_\_

Please indicate well location X.

ADDITIONAL INFORMATION

If more than one screen, show locations of each on sketch.