

CODED

WAYNE  
P65  
7-24-75

MISSISSIPPI  
BOARD OF WATER COMMISSIONERS  
416 North State Street  
13P Jackson, Mississippi 39201

WATER WELL DRILLERS LOG  
McILWAIN WATER WELL SERVICE

July 24, 1975 19  
date well completed

RT 2, BOX 335  
WAYNESBORO, MISS. 39367  
firm name

WAYNE  
county well located


LANDOWNER:	description of formations encountered	from	to
Mrs Irma Carol Reynolds	RED CLAY	0	14
RT 2 WAYNESBORO, Miss. (mailing address)	RED SAND	14	20
WELL LOCATION:	SAND, SOME CLAY	20	38
sec. 6 T 8 N R 5 E 8 miles E of W'BORO (distance) (direction) (nearest town)	COARSE SAND	38	45
WELL PURPOSE: HOME (home, irrigation, municipal, industrial)			
WELL COMPLETION DATA:			
(1) diameter (inches) 2"			
(2) total depth (feet) 45'			
(3) static water level (feet) 37' below top of ground.			
(4) casing PVC 40' (material) (depth) 2" If telescope see back. (size)			
(5) screen 5 40' (length) (depth to top) 2" PVC .008 (size) (material)			
(6) pump 3/4 7.5 (HP) (yield gpm) 110 AC (type power)			
(7) electric log NO (yes or no)			
(organization running log)			
(8) how well bottom plugged			
DRILLERS REMARKS:			

WAYNESBORO MISSISSIPPI  
AUG 19 1975

MISS. Bd. OF WATER COMMISSIONERS

If well telescopes please sketch and show depths.

GROUND LEVEL

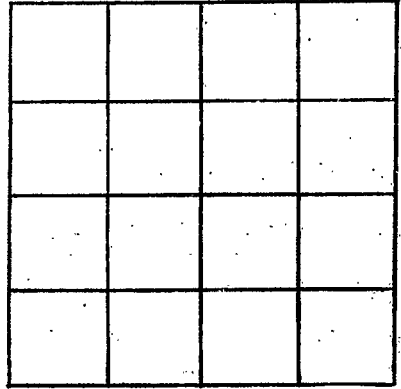

SECTION \_\_\_\_\_

Please indicate well location X.

ADDITIONAL INFORMATION

If more than one screen, show locations of each on sketch.