

Wayne
P 666
7-23-75

MISSISSIPPI
 BOARD OF WATER COMMISSIONERS **CODED**
 416 North State Street
 Jackson, Mississippi 39201

ele. 160

WATER WELL DRILLERS LOG

July 23 1975 Port Drilling Shop Wayne
 date well completed firm name county well located

LANDOWNER: Charley
Mr. Shuman
Rt 4 Waynesboro Miss
 (mailing address)

description of formations encountered	from	to
sand & clay	0	32
blue clay	32	42
rock stratum	42	65
blue clay	65	117
Trachyte	117	140
white clay	140	162
sandy clay	162	186
red wood	186	
white clay	186	196
blue clay	196	294
sub rock stratum	294	322
hard rock	322	324
sand & rock layers	324	337
rock	337	347
rock	347	350

WELL LOCATION:
 sec. 18 T 20 N R 5 13P
7 miles east of Waynesboro
 (distance) (direction) (nearest town)

WELL PURPOSE: Home
 (home, irrigation, municipal, industrial)


- WELL COMPLETION DATA:
- diameter (inches) 2"
 - total depth (feet) 350'
 - static water level (feet) 10 below top of ground. above
 - casing steel 323
 (material) (depth)
2' If telescope see back.
 (size)
 - screen wire mesh 12'
 (length) (depth to top)
 (size) (material)
 - pump 1/2 12 pump
 (HP) (yield gpm)
elec 20 gal flow
 (type power)
 - electric log no
 (yes or no)
 - (organization running log)
 - how well bottom plugged open

DRILLERS REMARKS:

MISS. DEPT. OF NATURAL RESOURCES
 AUG 26 1975

If well telescopes please sketch and show depths.

GROUND LEVEL

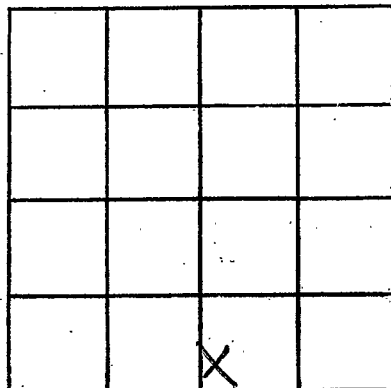

SECTION 18

Please indicate well location X.

ADDITIONAL INFORMATION

If more than one screen, show locations of each on sketch.