

Wayne  
 P 67  
 8-20-75

MISSISSIPPI  
 BOARD OF WATER COMMISSIONERS  
 416 North State Street  
 Jackson, Mississippi 39201

CODED

WATER WELL DRILLERS LOG


Aug 20 1975 date well completed  
 P. B. Drilling firm name  
 Wayne county well located

LANDOWNER: <u>Dr Leroy King</u>		description of formations encountered	from	to
<u>211 Buckatuna Miss</u> (mailing address)				
WELL LOCATION: sec <u>33</u> T <u>8</u> N R <u>5</u> E S <u>13</u> P <u>9</u> miles <u>SE</u> of <u>Waynesboro</u> (distance) (direction) (nearest town)		rest clay	0	1.8
WELL PURPOSE: <u>home</u> (home, irrigation, municipal, industrial)		sand + clay	1.8	3.5
WELL COMPLETION DATA: (1) diameter (inches) <u>2"</u>		clay	3.5	9.0
(2) total depth (feet) <u>104</u>		hard sand	9.0	10.4
(3) static water level (feet) <u>42</u> below top of ground.		that sand is to		
(4) casing <u>PVC</u> (material) <u>99'</u> (depth)		still in sand		
<u>2"</u> (size) if telescope see back.				
(5) screen <u>5'</u> (length) <u>99'</u> (depth to top)		<u>5' 1 1/2" b sand 5'</u>		
<u>1 1/4"</u> (size) <u>cast SS</u> (material)		screened on end of case		
(6) pump <u>1</u> (HP) <u>8</u> (yield gpm)		with back wash valve		
<u>elec</u> (type power)		one end x shell trap		
(7) electric log <u>no</u> (yes or no)		above		
(8) how well bottom/plugged <u>back wash valve</u>		<u>68' 1" P.V.C. logs</u>		
DRILLERS REMARKS: _____				

MISSISSIPPI  
 BOARD OF WATER COMMISSIONERS  
 AUG 26 1975  
 MISS. Bd. OF WATER COMMISSIONERS

If well telescopes please sketch and show depths.

GROUND LEVEL

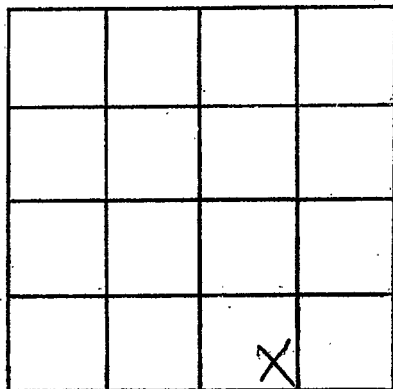

SECTION 33

Please indicate well location X.

ADDITIONAL INFORMATION

If more than one screen,  
show locations of each on sketch.