

CODED

Wayne
P 68'
9-10-75

MISSISSIPPI
BOARD OF WATER COMMISSIONERS
416 North State Street
Jackson, Mississippi 39201

WATER WELL DRILLERS LOG


Sept 10 1975
date well completed

McILWAIN WATER WELL SERVICE WAYNE

RT. firm name BOX 37
WAYNESBORO, MISS 39367


county well located

LANDOWNER:	description of formations encountered	from	to
Buddy Dearman RT 1 Bucatunna, Miss. (mailing address)			
WELL LOCATION: sec. 32 T 8 N R 5 W 13P 6 miles N of Bucatunna (distance) (direction) (nearest town)	Red Clay	0	5
WELL PURPOSE: HOME (home, irrigation, municipal, industrial)	Mixed Clay	5	9
WELL COMPLETION DATA: (1) diameter (inches) 2" (2) total depth (feet) 45' (3) static water level (feet) 32' below top of ground. (4) casing PVC 40' (material) (depth) 2" (size) if telescope see back. (5) screen 5' 40' (length) (depth to top) 2" PVC .010 (size) (material) (6) pump 1 10 (HP) (yield gpm) 220 AC (type power) (7) electric log no (yes or no) (organization running log) (8) how well bottom plugged	Sand	9	17
	Sand + Clay	17	25
	Sand	25	30
	Coarse Sand	30	45
DRILLERS REMARKS:			

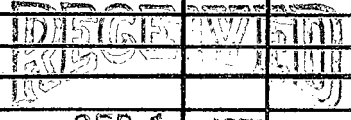

If well telescopes please sketch and show depths.

GROUND LEVEL

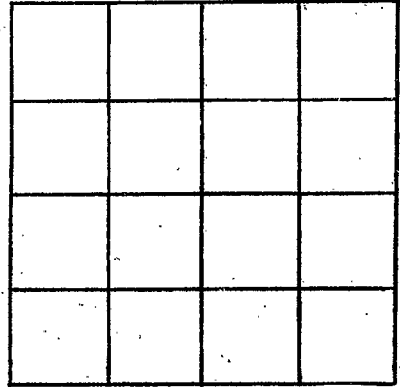

SECTION _____

Please indicate well location X.

ADDITIONAL INFORMATION

If more than one screen, show locations of each on sketch.